



Ellsworth **KANSAS**

Sec. 25 Twp. 17 R. 8W

Well No. #7 Janssen Farm

Elreco Company

E. K. Carey Contractor

Maes Pool


1140 Ft. from N. Line

..... Ft. from S. Line

..... Ft. from E. Line

1600 Ft. from W. Line

SW NE NW

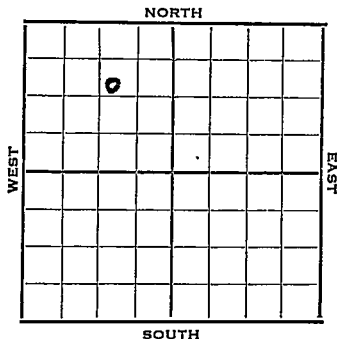

1953

Elev. 1744'

REPORT

7/8 MIRT

7/22 Heeb 2641, Tor 2663, Br li 2763, KC 2785, V 3192, Simp 3231, Arb 3298  
DST 3299-3305, 1/2 hrs., 1800' oil, 1000#  
RTD 3305  
5" @ 3298'

7/29 CO 3305, FU 1250' fluid 20",  
PB 3302

8/5 S/4 BO & 1 BWPH S/6 BOPH 4 hrs.

8/12 Spud 7-7-53 Oil well TD 3305  
8" @ 370 Heeb 2641 Tor 2663  
Br lime 2763 KC 2785 Viola 3192  
Simp. 3231 Arb. 3298  
DST 3299-3305 open 1/2 hr rec 1800'  
oil 1000# TD 3305 5" @ 3298  
CO to 3305 FU 1250' fluid 20 min  
PB 3302 S/4 BO 1 BWPH S/6 BOPH  
Comp. 313 BOPD

**COMPLETED**

County Ellsworth State Kansas

Sec. 25 (Blk. 17) (Sur. Rge.) 8W Map No.

Operator Elreco

Well No. 7 Farm Janssen

Elev. \_\_\_\_\_ Location SW NE NW


1140 Ft. From fn Line NW

1600 Ft. From fw Line Quarter

Ist. Report JUL 8 1953

Completion \_\_\_\_\_

Remarks \_\_\_\_\_

E. K. Carey - Contr.

Spudding Date \_\_\_\_\_

Drlg. Data Maes Pool

MIRT

J. G. McGEHEE

County Ellsworth State Kansas

Sec. 25 (Blk. 17) (Sur. Rge.) 8W Map No.

Operator Elreco

Well No. 7 Farm Janssen

Elev. 1744 Location SW NE NW


1140 Ft. From N Line NW

1600 Ft. From W Line Quarter

Ist. Report

Completion AUG 12 1953

Remarks Maes Pool

Carey - Contr.

Spudding Date 8-7-53

Drig. Data Oil well TD 3305

8" @ 370 Heeb. 2641 Tor. 2663

Br. lime 2763 KC 2785 Viola 3192

Simp. 3231 Arb. 3298 DST 3299-3305

open 1/2 hr. Rec. 1800' oil 1000#

TD 3305 5" @ 3298 CO to 3305 FU 1250'

fluid 20 min. PB 3302 S/ 4 bo

1 bwph / S/ 6 boph Comp. 313ibopd