

Section 25 Township 17 Range 2WWell No. #1 MorineCompany Musgrove Pet.

NORTH

8

						0	

WEST

EAST

SOUTH

McPherson KANSAS

SEC.	TWP.	R.
25	17	2W ✓

WELL NO.

1 Morine

FARM

COMPANY

Musgrove Petr.

CONTRACTOR

Musgorve


Roxbury Pool

Ft. from N. Line

330 Ft. from S. Line

990 Ft. from E. Line

Ft. from W. Line

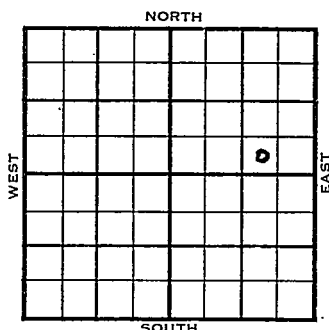

SW SE NE

1954	ELEVATION	REPORT
	1404'	

3/17 8" @ 162' WORT

3/24 WORT

4/7 Heeb 1943', Doug 1984'
rlg. 2321'

4/21 Spud 4-1-54 D & A TD 2756
 8" @ 162 Heeb 1943 Doug. 1984
 Miss. 2747
 DST 2749-52 open 1 hr rec 25' mud
 5' clean oil, 605# TD 2752
 5" @ 2749 GO to 2752 FU 150'
 fluid 12 hr. S/1 GO 11½ GWPB 5 hr.
 FU 208' fluid 12 hr. DD 2754
 wtr. inc. DD 2756 S/8 BWPB SSO
 5 hr. D & A

ABANDONED

County **McPherson** State **Kansas**Sec. **25** (Blk. Twp.) **17** (Sur. Rge.) **2W** Map No.Operator **Musgrove Pet.**Well No. **1** Farm **Morine**Elev. Location **SW SE NE**

330 Ft. From **S** Line **NE****990** Ft. From **E** Line **Quarter**1st. Report **MAR 17 1954**


Completion

Remarks

Musgrove - Contr.

Spudding Date

Drlg. Data **Roxbury Pool****8" @ 162 WORT**

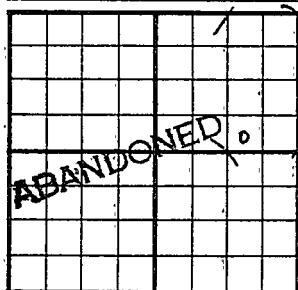County McPherson State KansasSec. 25 (Blk.
Twp.) 17 (Sur.
Rge.) 2W Map No.Operator Musgrove Pet.Well No. 1 Farm MorineElev. 1404 Location SW SE NE330 Ft. From S Line NE990 Ft. From E Line Quarter1st. ReportCompletion APR 21 1954Remarks Roxbury PoolMusgrove - Contr.Spudding Date 4-1-54Drlg. Data D & A TD 27568" @ 162 Heeb. 1943 Doug. 1984Miss. 2747 DST 2749-52 open 1 hr.Rec. 25' mud 5' clean oil 605#TD 2752 5" @ 2749 CO to 2752 FU 150'fluid 12 hr. S/ 1 go 11½ gwph 5 hr.FU 208' fluid 12 hr. DD 2754 wtr. inc.DD 2756 S/ 8 bwph SSO ' 5 hr.D & A