

Section 25 Township 17 Range 2WWell No. #1 NelsonCompany F.S.Williams et al

NORTH

						0	

SOUTH

16

WEST

EAST

Sec. 25 Twp. 17 R. 2W ✓

Well No. #1 Nelson Farm

F. S. Williams et al Company

Mallard Drlg. - Contr. Contractor

Semi-Wildcat


 Ft. from N. Line

330' Ft. from S. Line

990' Ft. from E. Line

 Ft. from W. Line

SW SE SE

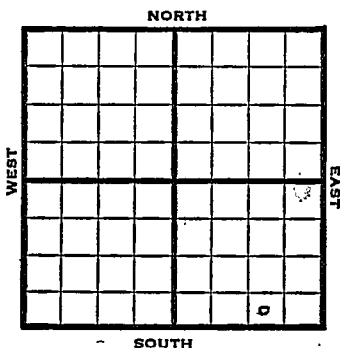

1950

Elev.

REPORT

10/18

RUR

11/1

Spud 10-16-50

D&A TD 2737

10" @ 136' KC 2125'

Miss 2712-15

7" @ 2713

TD 2737'

1400' wtr in hole

D&A

ABANDONED

County McPherson State Kansas

Sec. 25 (Blk. Twp.) 17 (Sur. Rge.) 2W Map No.

Operator **F. S. Williams et al.**

Well No. 1 Farm Nelson

Elev.	Location	SF	SE	SE

FIRST REPORT

330 Ft. From S Line SE

990 Ft. From E Line Quarter

1st. Report OCT 18 1950

Completion

Remarks

Mallard Drfg. - Contr.


Spudding Date _____

Drlg. Data Semi Wildcat

R U R

J. E. TYRA

County McPherson State Kansas
 Sec. 25 (Blk.) 17 (Sur.) 2W Map No.
 Operator F. S. Williams et al.
 Well No. 1 Farm Nelson
 Elev. Location SW SE SE

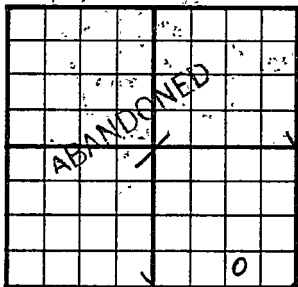

330 Ft. From S Line SE
990 Ft. From E Line Quarter
 1st. Report
 Completion NOV 1 1950
 Remarks Semi Wildcat
Mallard Drlg. - Contr.
 Spudding Date 10-16-50

Drlg. Data D & A TD 2737
10" @ 136 KC 2125 Miss. 2712-15
7" @ 2713 TD 2737 1400' water in hole

D & A

J. E. TYRA