


SECTION 25 TOWNSHIP 17S RANGE 2W

WELL NO. # 2 F. Anderson

COMPANY Donald T. Ingling

NORTH

SE SE ^{NW} NE

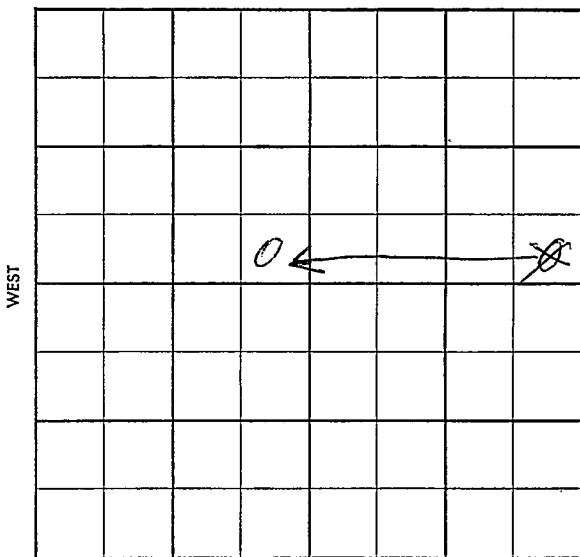

SOUTH

Top Pool
 Co. Facet
WILDCAT

S-513-B

County McPherson Elev. _____
 Sec. 25 Twp. 17 Rge. 2 W
 Company Donald T. Ingling
 Farm Name F. Anderson No. 2

TOPS	DEPTH	LOG	DATUM
Anh.			
Tp.			
H.			
Tr.			
Dg.			
B.L.			
L.			
K.C.			
B.K.C.			
Ce.			
C.			
M.			
M.			
K.			
Mz.			
Mq.			
V.			
S.			
S.			
A.			
R.			
Pf.			
G.			
T.D.			

Loc. in Sec. _____
SE SE NE
 Geol. _____
 Contr. _____
Co. tools
 Pool _____
Wildcat

FIRST REPORT
 MAY 28 1958

Date Comm. _____
Location

Co. _____
 Lse. _____
 No. _____
 Sec. _____
 T. _____
 R. _____

CORRECTION

Twp. ~~X~~ Pool. ~~X~~
 Co. ~~X~~ Facet. ~~X~~

S-513-B

County McPherson Elev. 1386 DF 1389 RB
 Sec. 25 Twp. 17 Rge. 2 W
 Company Donald T. Ingling
 Farm Name F. Anderson No. 2

TOPS	DEPTH	LOG	DATUM
Anh.			
Tp.			
H.	1937		
Tr.			
Dg.	1971		
B.L.	2093		
L.			
K.C.	2153		
B.K.C.			
Ce.			
C.			
M.	Chat 2748		
M.	dolo 2751		
K.			
Mz.			
Mq.			
V.			
S.			
S.			
A.			
R.			
Pf.			
G.			
T.D.	2777		

Loc. in Sec. SE SE NE
SE SE NW

Geol. _____
 Contr. _____
 Co. tools _____
 Pool. _____
Wildcat

ABANDONED
 ← X
 JUN 11 58

Date Comm. 5-28-58
 Location JUN 3 58 8" 167/75 JUN 11 58

DST 2748 - 56 w/ hr 205' USOC
SW BHP 610 log.

D&A

Co. No. Sec. T. R.