


Section 25 Township 17 Range 8 W

Well No. # 6 Jansen

Company Eldorado Ref.

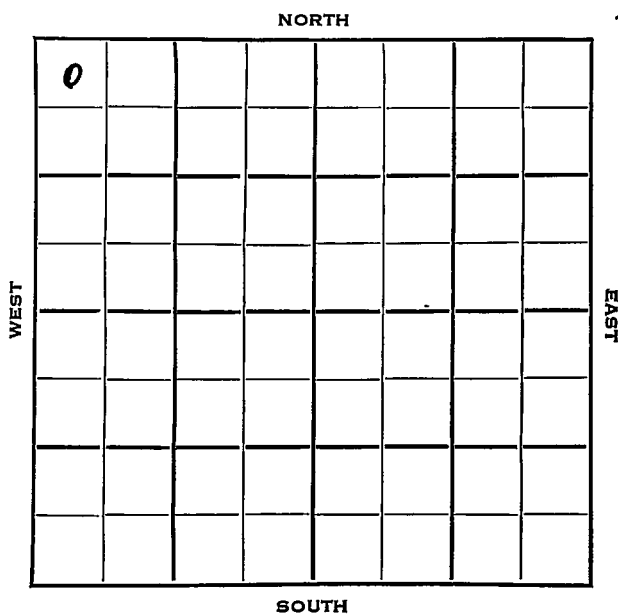

Sec. 25 Twp. 17 R. 8W

Well No. #6 Jansen Farm

Eldorado Ref. Company

Carey Drlg. Contractor

Maes Pool


330 Ft. from N. Line

_____ Ft. from S. Line

_____ Ft. from E. Line

330 Ft. from W. Line

NW NW NW

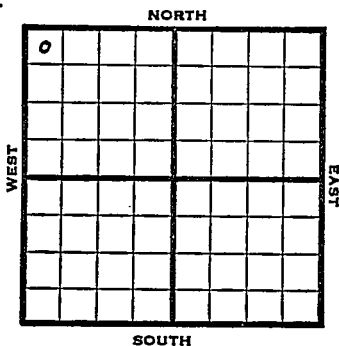

1953

Elev. 736'

REPORT

6/3

C&P

6/24

8" @ 345'
Heeb 2638, Br. L. 2764, KC 2789,
V. 3181, Simp 3220, Arb 3280-82
RTD

5" @ 3282'
DD 3283 $\frac{1}{2}$ 1250' oil, 1-3/4 hrs.
DD 3285 TD FU 2100' oil.

7/1

Spud 6-11-53 Oil well TD 3293
8" @ 345 Heeb 2638 Br lime 2764
KC 2789 Viola 3181 Simp 3220
Arb. 3280 TD 3282 5" @ 3282
DD 3283 FU 1250' oil, 1-3/4 hr.
DD 3285 FU 2100' oil DD 3293
FU 2980' oil S/74 BOPH
Comp. 3000 BOPD

COMPLETED

County Ellsworth State Kansas

Sec. 25 (Blk. 17 (Sur. Rge.) 8W Map No.

Operator Eldorado Ref.

Well No. 6 Farm Jansen

Elev. 1736 Location NW NW NW

o					

COMPLETE

330 Ft. From N Line NW

330 Ft. From W Line Quarter

Ist. Report

Completion JUL 1 1953

Remarks Maes Pool

Carey Drlg. - Contr.

Spudding Date 6-11-53

Drlg. Data Oil well TD 3293

8" @ 345 Heeb. 2638 Br. lime 2764

KC 2789 Viola 3181 Simp. 3220

Arb. 3280 TD 3282 5" @ 3282 DD 3283

FU 1250' oil 1 3/4 hr. DD 3285

FU 2100' oil DD 3293 FU 2980' oil

S/ 74 boph Comp. 3000 bopd