

KANSAS

FORM 51 5M 10-41 PETROL


McPherson

Section 25 Township 17 Range 4-W

Well No. #1 Bean Estate

Company Falcon Seaboard etal

Wildcat

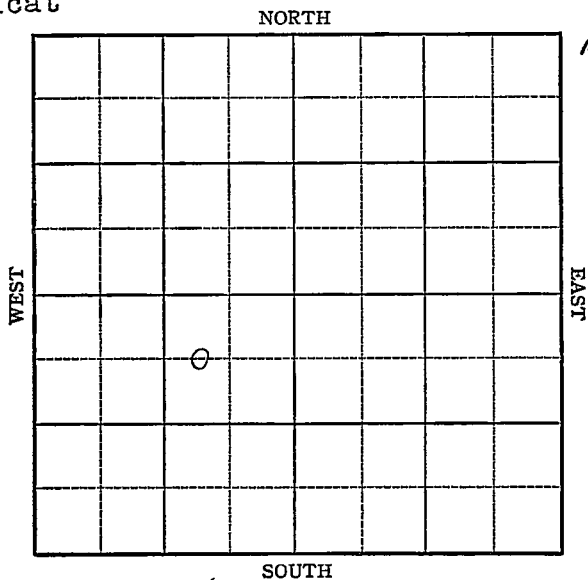

Sec. 25 Twp. 17. R. 4W

Well No. #1-Bean Estate Farm

Falcon Seaboard et al Company

(Wildcat)


660 Ft. from N. Line

 Ft. from S. Line

990 Ft. from E. Line

 Ft. from W. Line

C $W\frac{1}{2}$ NE SW v. 1352

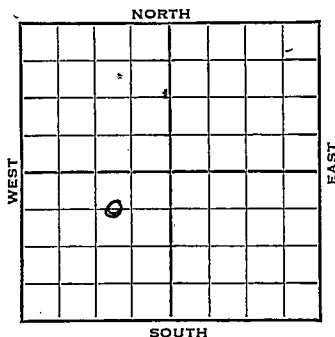

1942	Elev 1352	REPORT
9/30		Rotary Derrick
10/7		12" - 143 Drlg. 1490
10/14		Drlg. 2925'
10/21		Miss 2955, Kind 3195, Viola 3403-10 SO Simp sd. 3546 TD 3548
10/28	Arb 3603-5" @ 3461'	TD 3615 30 shots 3401-06-3300' oil 4 hrs
11/4	Arb 3606'	5" @ 3461' Viola 3403' 30 shots 3401-06 Echo Pot 3377' Max 3000 35 ⁸ Gr TD 3615'

COMPLETED

KANSAS

McPherson

Map No. 44 Sec. 25 Twp. 17 R. 4WWell No. 1 Bean EstateFalcon Seaboard et al. Company

Contractor

C $W\frac{1}{2}$ NE SW

SECTION PLAT

660 Ft. from N. Line

_____ Ft. from S. Line

990 Ft. from E. Line

_____ Ft. from W. Line

WILD CAT

	0		

Location _____

Rig up _____

Drilling and Remarks:

Derrick
Rotary

RECORD

Cased _____ in., _____ ft.

Sand _____

Gas _____

Oil _____

Total Depth _____

PRODUCTION

1st 24 hrs. Nat. _____

1st 24 hrs. after shot _____

Gas _____ Cu. Ft.

Dry Hole _____

Abandoned _____

Date

FIRST REPORTS

SEP 3 0 1942 19

S. J. LEWIS Scout

McPherson

Map No. 44 Sec. 25 Twp. 17 R. 4W

Well No. 1 Bean Estate

Falcon-Seaboard etal. Company

Glendon & Ray will operate Contractor

C W $\frac{1}{2}$ NE SW

COMPLETION PLAT

660 Ft. from N. Line

 Ft. from S. Line

990 Ft. from E. Line

 Ft. from W. Line

	0		

WILDCAT

Location

Rig up

Drilling and Remarks:

*Core & 3603
5" 03 1/2 61
Mud 3403
30s to 3401-04
Echo 2 & 3377.
Max 3000*

RECORD

Cased in., ft.

Sand

Gas

Oil

Total Depth 3615

PRODUCTION

1st 24 hrs. Nat.

1st 24 hrs. after shot

Gas Cu. Ft.

Dry Hole

Abandoned

Date 05 Feb

NOV 4 1942 19

S. J. LEWIS Scout