

KANSAS


FORM 51 IOM 12-46 PETROL

Ellsworth

Section 26 Township 17 Range 10-W

Well No. #3 Decker


Company Texas

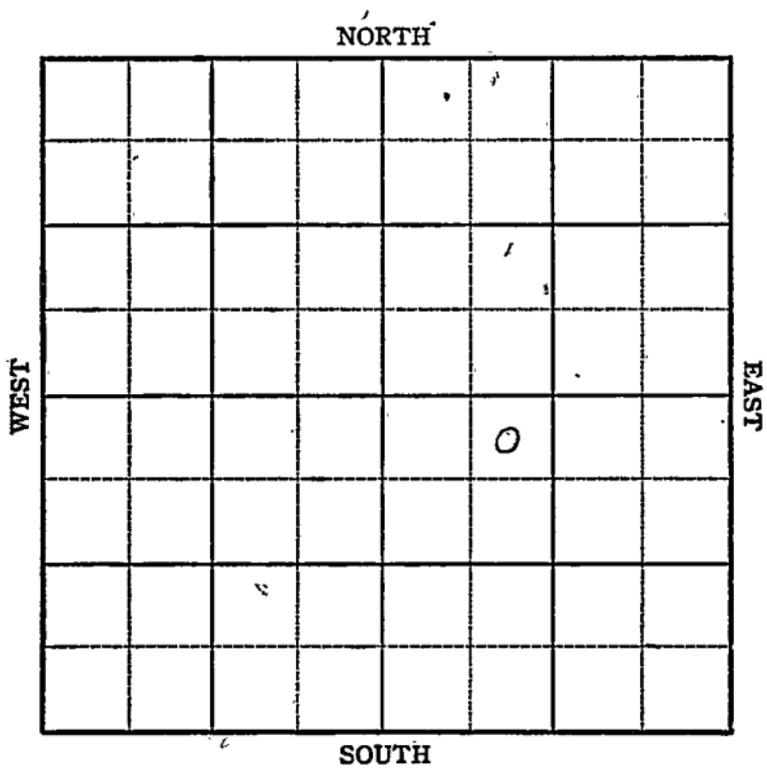

Sec. 26 Twp. 17 R. 10-W

Well No. #3 Decker Farm
Texas Company
Stoltenberg

330 Ft. from N. Line
Ft. from S. Line
Ft. from E. Line
990 Ft. from W. Line

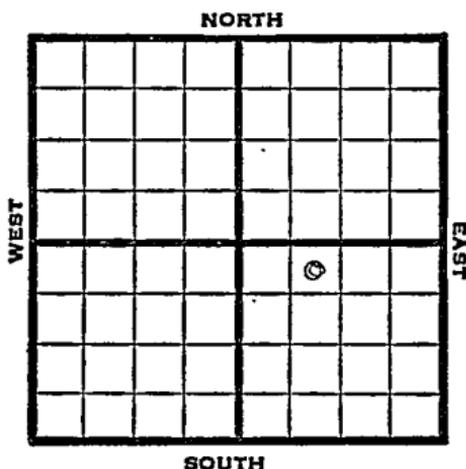

NE NW SE

REPORT

1947 Elev. 1784

2/19 Location

2/26 8" @ 265'
Drlg 1000'

3/4 Drlg 3046'

3/11 Lans 2908'
Arb 3254'
TD 3306'
RUST

3/19 Arb 3254
TD 3306'

ABANDONED

Kansas **KANSAS**

Stoltenberg

Map No. 55 Sec. 26 Twp. 17 R. 10WWell No. 3 DeckerTexas

Company

FIRST REPORT

Contractor

NE NW SE

SECTION PLAT330 Ft. from N. Line Ft. from S. Line Ft. from E. Line990 Ft. from W. Line

		o	

Ellsworth CountyLocation XRig up Drilling and Remarks: **RECORD**Cased in, ft.Sand Gas Oil Total Depth **PRODUCTION**1st 24 hrs. Nat. 1st 24 hrs. after shot Gas Cu. Ft.Dry Hole Abandoned

Date

FEB 19 1947S. J. LEWIS Scout

Map No. 55 Sec. 26 Twp. 17 R. 10W

Well No. 3 Decker

Texas Company

ABANDONED

Contractor

NE NW SE

E. 11784

SECTION PLAT

330 Ft. from N. Line

_____ Ft. from S. Line

_____ Ft. from E. Line

990 Ft. from W. Line

		o	

Ellsworth County

Location _____

Rig up _____

Drilling and Remarks:

Cor 43254

RECORD

Cased _____ in., _____ ft.

Sand _____

Gas _____

Oil _____

Total Depth 3306

PRODUCTION

1st 24 hrs. Nat. _____

1st 24 hrs. after shot _____

Gas _____ Cu. Ft.

Dry Hole _____

Abandoned _____

Date

MAR 1 9 1947 19

S. J. LEWIS Scout