

Section 26 Township 17 Range 10W

Well No. 1 Stueder

Company El Dorado Ref.

NORTH

							0

WEST

EAST

SOUTH

Ellsworth **KANSAS** ✓Sec. 26 Twp. 17 R. 10WWell No. 1 Stueder FarmEldorado Ref. CompanySterling Drlg - Contr. ContractorHeiken Pool

NORTH


990 Ft. from N. Line

Ft. from S. Line

330 Ft. from E. Line

Ft. from W. Line

SE NE NE

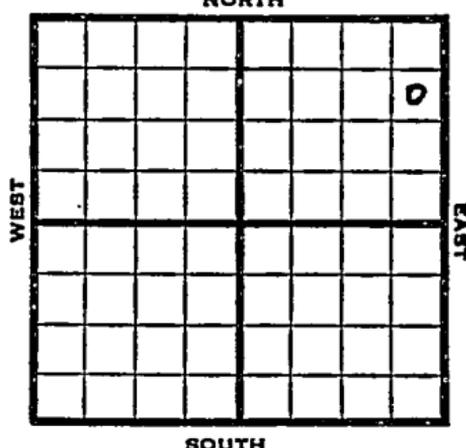

1953 Elev. 1761: REPORT

- 4/1 . 8" @ 270
- 4/8 Anhy 475'
Drlg. 3150'
- 4/16 Heeb 2744, Tor 2763, Br li 2859,
Lans 2877, Cong 3183, Arb. 3210
RTD 3217
5" @ 3213
DD 3222 TD
FU 1300' oil + 400' wtr.
- 4/23 NR
- 4/30 S/2-3/4 BO plus 3/4 BWPH 6 hrs.
FU 1150' oil plsu 300' wtr. POP
- 5/6 Spud 3-29-53
Oil Well
TD 3222
8" @ 270
Anhy 475, Heeb 2744, Tor 2763, Br
lime 2859, Lans 2877, Cong 3183,
Arb. 3210
TD 3217
5" @ 3213
D D 3222, FU 1300' oil, 400' wtr.
S/ 2-3/4 bo 3/4 bwph 6 hrs.
FU 1150' oil 300' wtr.
Comp. 132 bopd 15% wtr.

COMPLETED

County Ellsworth State Kansas

Sec. 26 (Blk. Twp.) 17 (Sur. Rge.) 10W Map No.

Operator El Dorado Ref.

Well No. 1 Farm Stueder

Elev. Location SE NE NE

FIRST REPORT

990 Ft. From N Line NE

330 Ft. From E Line Quarter

Ist. Report APR 1 1953

Completion

Remarks

Sterling Drlg. - Contr.

Spudding Date 3-29-53

Drlg. Data Heiken Pool

8" @ 270

J. G. McGEHEE

Scout Cards	RP
Land Small Map	
Land Wall map	B
Trailings	
France Map	
Pierce Map	
Misc.	

APR 6 1953

MAY 12 1953

Scout Cards	AD
Land Small Map	
Land Wall Map	3
Tracings	
France Map	
Pierce Map	
Misc.	

Orig. Date