

Ellsworth

Map No. KANSAS Sec. 26 Twp. 17 R. 10^W

Well No. 1 - Sturn Farm

Slick, Preps & Lockhart Company


330 Ft. from N. Line

_____ Ft. from S. Line

_____ Ft. from E. Line

330 Ft. from W. Line

Elev. 1816

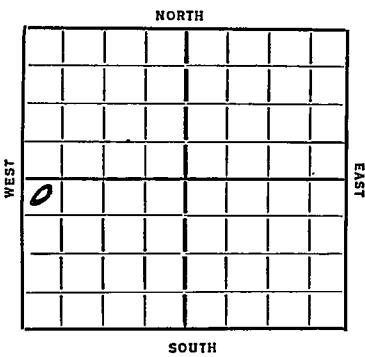

Date	REPORT
1935	
9/29	Eller
10/3	Rgn
10/19	
11/1	20" 160 15" 335
	delg 525 15" 370
11/7	" 1375 18" 1275
11/14	" 2295 10" 1866
11/21	" 2990
11/29	6" 3284 40 3278-81
	Top Sil 3322 40-3330-34
	40 W 3336-39
12/6	SD 3363
12/11	T. Sil 3322
	TD 3363
	D. & A.
	ABANDONED

E. Stewart
Map No. 55 Sec. 26 Twp. 17 R. 10W
Well No. 1 - Sturm
Slick, Pumps & Lockhart Company

Contractor

FIRST REPORTS

330 Ft. from N. Line

..... Ft. from S. Line

..... Ft. from E. Line

330 Ft. from W. Line

SECTION PLAT

0			

Location.....

Rig up.....

Drilling and Remarks:

cellar

RECORD

Cased..... in., ft.

Sand.....

Gas.....

Oil.....

Total Depth.....

PRODUCTION

1st 24 hrs. Nat.....

1st 24 hrs. after shot.....

Gas..... Cu. Ft.

Dry Hole.....

Abandoned.....

Date

ORVAL MANNSCHRECK

9-20-30 192.....

Scout

Map No. 53 Sec. 26 Twp. 17 R. 10 W

Well No. 1 - Sturm

Slick Pryor & Lockhart Company

Contractor

SECTION PLAT

0			

330 Ft. from N. Line

..... Ft. from S. Line

..... Ft. from E. Line

330 Ft. from W. Line

COMPLETED

RECORD

Location.....

Cased..... in., ft.

Rig up.....

Sand T. Sil 3322

Drilling and Remarks:

Gas.....

Oil.....

Total Depth 3363

D. & A.

PRODUCTION

1st 24 hrs. ^{4*} Nat.....

1st 24 hrs. after shot.....

Gas..... Cu. Ft.

Dry Hole.....

Abandoned 3363

Date

ORVAL MANNSCHRECK

12-11-35 192

Scout

no wall

[Handwritten scribble]

Returned	<i>[Signature]</i>
Cards	<i>[Signature]</i>
Tracing	<i>[Signature]</i>
France Map	<i>[Signature]</i>
Scarborough Map	<i>[Signature]</i>
Moody Map	<i>[Signature]</i>
Scarborough Plat Book	
Woody Plat Book	