


KANSAS

Ellsworth

Section 26 Township 17 Range 9W

Well Number #5 Odgen

Company Carter

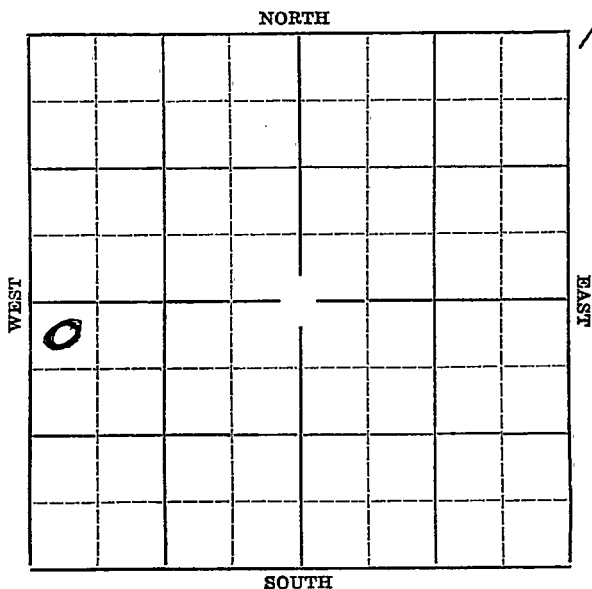


Map No. KANSAS Sec. 26 Twp. 17 R. 9WWell No. #5 Odgen FarmCarter Oil Company Company330' Ft. from N. Line

Ft. from S. Line

Ft. from E. Line

330' Ft. from W. Line

Elev. 1754

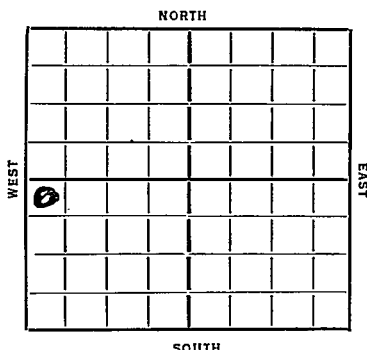Date
1936

REPORT

6/3 Cellar.

6/11 198'. of 10". 210'. WAIT ON CEMENT

6/18 Drlg. 1875'.

6/25 Drlg. 3014'.

7/2 Sil. 3150'. and T.D. 3153'. RUST.

7/9 3160'. T.D. 2800'. Oil. 1000 gal-
lons of acid. No test.7/16 T.D. 3162'. ~~10~~ 160 bbls of oil in
8 hours.

7/23 3166'. Hole full of oil.

7/29/36-Sil. 3150'.

1000 gallons of acid.

T.D. 3166'.

Potential 1294 bbls in 22 hours

COMPLETED

Map No. 43 Sec. 26 Twp. 17 R. 9WWell No. 5 OelgenCarter Company

Contractor

SECTION PLAT

0			

330 Ft. from N. Line

_____ Ft. from S. Line

_____ Ft. from E. Line

330 Ft. from W. Line

FIRST REPORT

Location _____

Rig up _____

Drilling and Remarks:

Oelgen

RECORD

Cased _____ in., _____ ft.

Sand _____

Gas _____

Oil _____

Total Depth _____

PRODUCTION

1st 24 hrs. Nat. _____

1st 24 hrs. after shot _____

Gas _____ Cu. Ft.

Dry Hole _____

Abandoned _____

Date

JUN 3 1936

19

S. J. LEWIS

Scout

Edwards
Form 26-12M-Exs. 2-29

KANSAS

Map No. *#5* Sec. *26* Twp. *17* R. *9W*

Well No. *5 Odgen*

Cartel Company

Contractor

SECTION PLAT

<i>o</i>			

330 Ft. from N. Line

_____ Ft. from S. Line

_____ Ft. from E. Line

330 Ft. from W. Line

COMPLETED

Location _____

Rig up _____

Drilling and Remarks:

S. L 3150

1000 acid

Pa 8/294-22/42

RECORD

Cased _____ in., _____ ft.

Sand _____

Gas _____

Oil _____

Total Depth *3166*

PRODUCTION

1st 24 hrs. Nat. _____

1st 24 hrs. after shot _____

Gas _____ Cu. Ft.

Dry Hole _____

Abandoned _____

Date

JUL 29 1936 19

S. J. LEWIS Scout