


Section 26 Township 17 Range 9W

Well Number 8 Odgen

Company Carter Oil et al

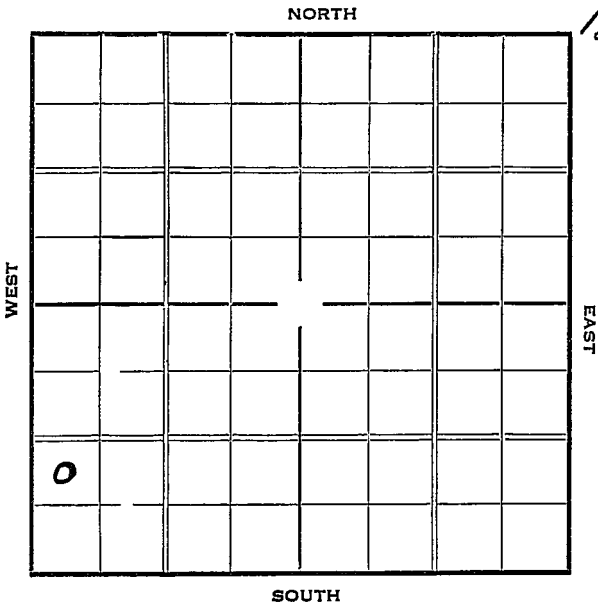


Sec. 26 Twp. 17 R. 9-W

Well No. #8 Odgen Farm
Carter Oil et al Company

 Ft. from N. Line
990 Ft. from S. Line
 Ft. from E. Line
330 Ft. from W. Line

Elev. 1765

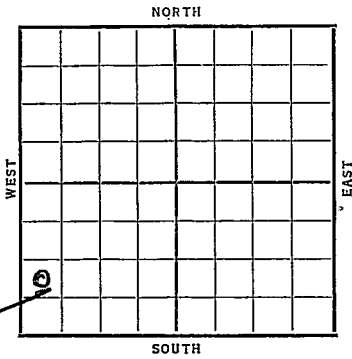

Date	REPORT
2/3	Location
2/11	ROG
2/19	Rigging up.
2/26	10" @ 218. Drlg. 553'.
3/4	Drlg. 2395'
3/11	Drlg. 2850'.
3/18	Drlg. 3105'
3/25	Sil. 3168'. 7" @ 3166'.
	T. u. 3181'. RUST. Hole full
	oil.
3/31	Sil. 3168'.
	T. u. 3181'.
	1000 acid.
	Potential 965.
	COMPLETED

Form 26-1M Bks. 7-29 **KANSAS**

Map No. 45 Sec. 26 Twp. 17 R. 9W

Well No. J Oelgen

Carter Oil & Co Company

Contractor

SECTION PLAT

		9'	10'
0			

_____ Ft. from N. Line

990 Ft. from S. Line

_____ Ft. from E. Line

930 Ft. from W. Line

FIRST REPORT

Location ✓

Rig up _____

Drilling and Remarks:

RECORD

Cased _____ in., _____ ft.

Sand _____

Gas _____

Oil _____

Total Depth _____

PRODUCTION

1st 24 hrs. Nat. _____

1st 24 hrs. after shot _____

Gas _____ Cu. Ft.

Dry Hole _____

Abandoned _____

Date

FEB 3 1937 19

S. J. LEWIS Scout

KANSAS *Ellsworth*

Map No. 45 Sec. 26 Twp. 17 R. 9W

Well No. 8 Oclg sm

Cartel Company

Contractor

SECTION PLAT

o			

_____ Ft. from N. Line

990 Ft. from S. Line

_____ Ft. from E. Line

330 Ft. from W. Line

COMPLETED

RECORD

Cased _____ in., _____ ft.

Sand _____

Gas _____

Oil _____

Total Depth 3181

PRODUCTION

1st 24 hrs. Nat. _____

1st 24 hrs. after shot _____

Gas _____ Cu. Ft.

Dry Hole _____

Abandoned _____

Location _____

Rig up _____

Drilling and Remarks:

Sil 2168
1000 acid
Potential
965

Date

MAR 31 1937 ₁₉

S. I. LEWIS Scout