


Ellavorth

Form 51-5M-5-34-Palace

Map No. **KANSAS** Sec. **26** Twp. **17** R. **9W**

Well No. **1- Ogden** Farm
Carthage state Company

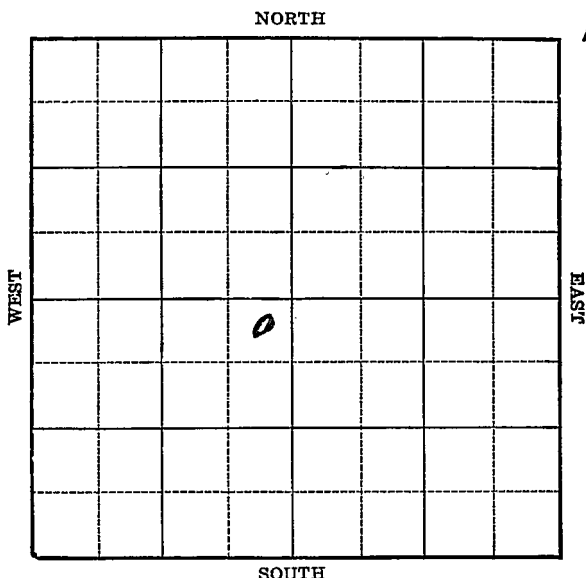

Location _____

Drilling Remarks

RECORD

Cased _____ in. _____ ft.

Sand _____

Gas _____

Oil _____

Total Depth _____

Rig Up _____

Drilling Remarks

PRODUCTION

1st 24 hrs. Nat. _____

1st 24 hrs. after shot _____

Gas _____ cu. ft.


Dry Hole _____

Abandoned _____

Well No. 1- Ogden Farm
Carter et al Company

NORTH

Ft. from W. Line

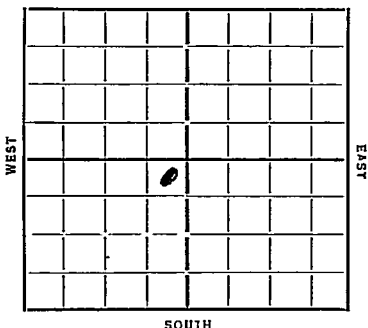

REPORT

163 1000

COMPLETED

KANSAS

Ellsworth
 Map No. *45* Sec. *26* Twp. *17* R. *9W*
 Well No. *109 den*
Carter et al Company

Contractor

FIRST REPORT

SECTION PLAT

	0		

440 Ft. from N. Line

Ft. from S. Line

440 Ft. from E. Line

Ft. from W. Line

Location

Rig up

Drilling and Remarks:

Material

RECORD

Cased in., ft.

Sand

Gas

Oil

Total Depth

PRODUCTION

1st 24 hrs. Nat.

1st 24 hrs. after shot

Gas Cu. Ft.

Dry Hole

Abandoned

Date

4-24-35 192ORVAL MANNSCHRECK
Scout

Map No. 45 Sec. 26 Twp. 17 R. 9WWell No. 1- OgdenCarter oil

Company

Contractor

SECTION PLAT

440 Ft. from N. Line

Ft. from S. Line

440 Ft. from E. Line

Ft. from W. Line

Location

Rig up

Drilling and Remarks:

723 bbls

RECORD

Cased _____ in. _____ ft.

Sand oil 3183

Gas _____

Oil _____

Total Depth 3187

PRODUCTION

1st 24 hrs. Nat. _____

1st 24 hrs. after shot _____

Gas _____ Cu. Ft.

Dry Hole _____

Abandoned _____

Date

ORVAL MANNSCHRECK

7-17-35 192

Scout