

Ellsworth

Map No. KANSAS Sec. 26 Twp. 17 R. 9W

Well No. 3-Open Farm _____
Carter et al Company _____


_____ Ft. from N. Line

1320 Ft. from S. Line

_____ Ft. from E. Line

1320 Ft. from W. Line

Elev. 1758

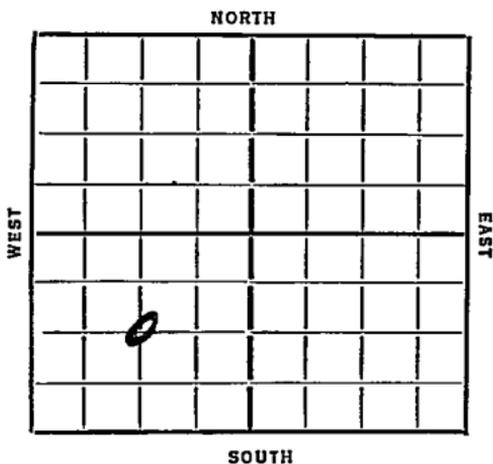

REPORT

Date	Description
<u>1/26</u>	
<u>2/5</u>	Location
<u>2/14</u>	GM Material
<u>2/21</u>	—
<u>2/28</u>	BP
<u>3/6</u>	Rig
<u>3/13</u>	10 th -198 Drlg. 1010
<u>3/20</u>	2780 Drlg.
<u>3/27</u>	T. Simp. 3155' T. Sil. 3160' 7 th - 3159 RUST T.D. 3163'
<u>4/2</u>	T.D. 3166' HFW. 12 Hrs. Taking pot.
<u>4/8</u>	Sil 3160 T.D 3166 1000 acid Pot 1596 Pbls.

COMPLETED

Map No. 45 Sec. 26 Twp. 17 R. 9W

Well No. 3 - Ogden

Carter et al. Company

..... Contractor


SECTION PLAT

..... Ft. from N. Line

1320 Ft. from S. Line

..... Ft. from E. Line

1320 Ft. from W. Line

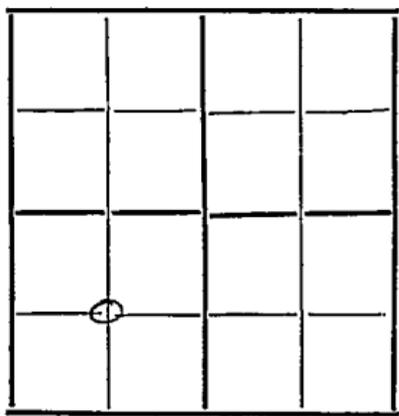

FIRST REPORT

Location.....

Rig up.....

Drilling and Remarks:

RECORD

Cased.....in.,ft.

Sand.....

Gas.....

Oil.....

Total Depth.....

PRODUCTION

1st 24 hrs. Nat.....

1st 24 hrs. after shot.....

Gas.....Cu. Ft.

Dry Hole.....

Abandoned.....

Date

FEB 5 1936 192.....

ORVAL MANNSCHRECK
.....Scout

Map No. 45 Sec. 26 Twp. 17 R. 9W

Well No. 3 Ogden

Carter Oil Company

Contractor


SECTION PLAT

..... Ft. from N. Line

1820 Ft. from S. Line

..... Ft. from E. Line

1820 Ft. from W. Line

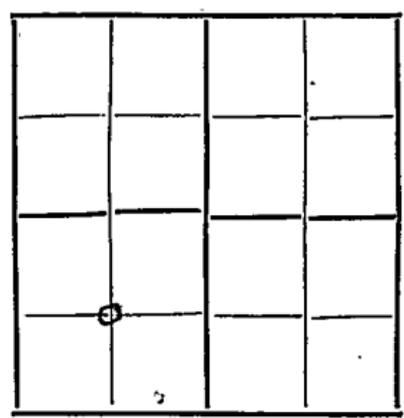

COMPLETED

Location.....

Rig up.....

Drilling and Remarks:

Oil: 3160
1000 acid
Potential
1596 yk

RECORD

Cased..... in., ft.

Sand.....

Gas.....

Oil.....

Total Depth 3166

PRODUCTION

1st 24 hrs. Nat.....

1st 24 hrs. after shot.....

Gas..... Cu. Ft.

Dry Hole.....

Abandoned.....

Date

4/8/26 192

S. J. LEWIS Scout