


Form 51-5M-3-35-Mid-West

NORTH

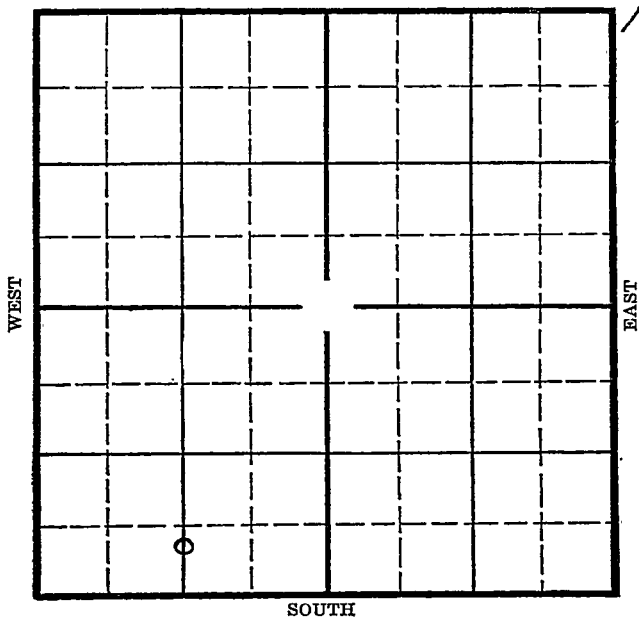

Rig Up _____
Drilling Remarks

PRODUCTION

1st 24 hrs. Nat. _____

1st 24 hrs. after shot _____


Gas _____ cu. ft. _____

Dry Hole _____

Abandoned _____

Map No. KANSAS Sec. 26 Twp. 17 R. 9-WWell No. 4-Ogden Farm
Carter Oil Company Ft. from N. Line440 Ft. from S. Line Ft. from E. Line1320 Ft. from W. Line

Elev. 1764

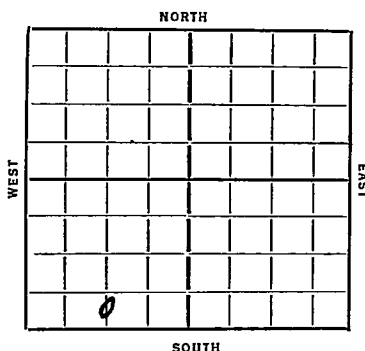Date
1936

REPORT

4/8 Location

4/16 B.R.

4/23 Drlg. 219'

4/30 Drlg. 2090'

5/7 Drlg. 3161'.

5/14 Simpson 3173'. 7" @ 3176'. Sil.
3178'. T.D. 3182'. 2300' oil in 3
hours.

5/20/36 Sil. 3173'.

1000 gallons acid.

T.D. 3182'.

1251* Potential.

COMPLETED

Map No. 45 Sec. 26 Twp. 17 R. 9 W

Well No. 4 Ogden

Carter Oil Company

Contractor

SECTION PLAT

.....Ft. from N. Line

440 Ft. from S. Line

.....Ft. from E. Line

1820 Ft. from W. Line

FIRST REPORT

Location ✓

Rig up

Drilling and Remarks:

RECORD

Cased.....in.,ft.

Sand.....

Gas.....

Oil.....

Total Depth.....

PRODUCTION

1st 24 hrs. Nat.....

1st 24 hrs. after shot.....

Gas.....Cu. Ft.

Dry Hole.....

Abandoned.....

Date

4/8/26 192.....

S. J. LEWIS

Scout

Map No. 45 Sec. 26 Twp. 17 R. 5WWell No. 4 OalgenCarter

Company

Contractor

SECTION PLAT

_____ Ft. from N. Line

440 Ft. from S. Line

_____ Ft. from E. Line

1320 Ft. from W. Line

COMPLETED

Location _____

Rig up _____

Drilling and Remarks:

Sil 31731000 acid1251 P.J.

RECORD

Cased _____ in., _____ ft.

Sand _____

Gas _____

Oil _____

Total Depth 3182

PRODUCTION

1st 24 hrs. Nat. _____

1st 24 hrs. after shot _____

Gas _____ Cu. Ft.

Dry Hole _____

Abandoned _____

Date

MAY 20 193619S. J. LEWISScout