


Ellsworth KANSAS

Section 26 Township 17 Range 9-W

Well Number 7 Ogden

Company Carter Oil

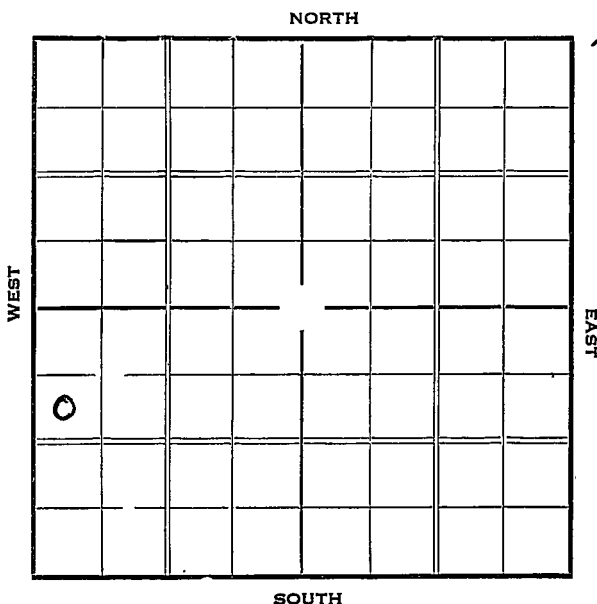

Map No. \_\_\_\_\_ Sec. 26 Twp. 17 R. 9-W

Well No. #7 Ogolen Farm \_\_\_\_\_


Carter Oil Company \_\_\_\_\_

990 Ft. from N. Line

\_\_\_\_\_ Ft. from S. Line

\_\_\_\_\_ Ft. from E. Line

330 Ft. from W. Line

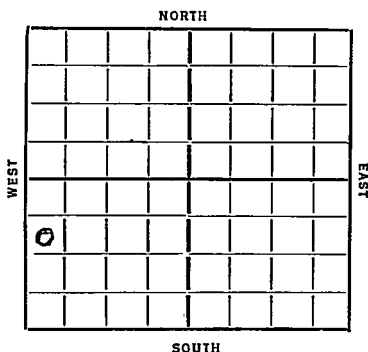

Date	REPORT
1936	
12/22	R O G
12/29	Rigging up
1937	
1/7	10" @ 205'. Drlg. 1275'.
1/14	Drlg. 3105'.
1/21	Sil. 3149'. 7" @ 3151'.
	T. D. 3154'. RUST.
1/28	Hole full oil 3165'.
2/4	Pump 315 bbls. 9 hrs.
2/11	787 bbls. natural 1000 acid.
	No Test.
2/17	Sil. 3149'.
	T. D. 3165'.
	1000 acid.
	Potential 1339.
	<b>COMPLETED</b>

Map No. 45 Sec. 26 Twp. 17 R. 9W

Well No. 7 Ogden

Carter O.C. Company

Contractor

**SECTION PLAT**

990 Ft. from N. Line  
 \_\_\_\_\_ Ft. from S. Line  
 \_\_\_\_\_ Ft. from E. Line  
330 Ft. from W. Line

0			

**FIRST REPORT**

Location \_\_\_\_\_

Rig up \_\_\_\_\_

Drilling and Remarks:

*ROG*

**RECORD**

Cased \_\_\_\_\_ in., \_\_\_\_\_ ft.

Sand \_\_\_\_\_

Gas \_\_\_\_\_

Oil \_\_\_\_\_

Total Depth \_\_\_\_\_

**PRODUCTION**

1st 24 hrs. Nat. \_\_\_\_\_

1st 24 hrs. after shot \_\_\_\_\_

Gas \_\_\_\_\_ Cu. Ft.

Dry Hole \_\_\_\_\_

Abandoned \_\_\_\_\_

Date

DEC 22 1936 19

S. J. LEWIS Scout

Map No. 45 Sec. 26 Twp. 17 R. 9W

Well No. 7 Ogden

Carter Oil Company

Contractor

**SECTION PLAT**

990 Ft. from N. Line

\_\_\_\_\_ Ft. from S. Line

\_\_\_\_\_ Ft. from E. Line

330 Ft. from W. Line

0			

**COMPLETED**

Location \_\_\_\_\_

Rig up \_\_\_\_\_

Drilling and Remarks:

*Sil 3149*  
*1000 acid*  
*Potential*  
*1339*

**RECORD**

Cased \_\_\_\_\_ in., \_\_\_\_\_ ft.

Sand \_\_\_\_\_

Gas \_\_\_\_\_

Oil \_\_\_\_\_

Total Depth 3165

**PRODUCTION**

1st 24 hrs. Nat. \_\_\_\_\_

1st 24 hrs. after shot \_\_\_\_\_

Gas \_\_\_\_\_ Cu. Ft.

Dry Hole \_\_\_\_\_

Abandoned \_\_\_\_\_

Date

**FEB 17 1937** 19

**S. J. LEWIS** Scout