

Ellsworth

Map No. KANSAS Sec. 26 Twp. 17 R. 9W


Well No. 1 Teubner Farm.
Carter et al Company

_____ Ft. from N. Line

440 Ft. from S. Line

440 Ft. from E. Line

_____ Ft. from W. Line

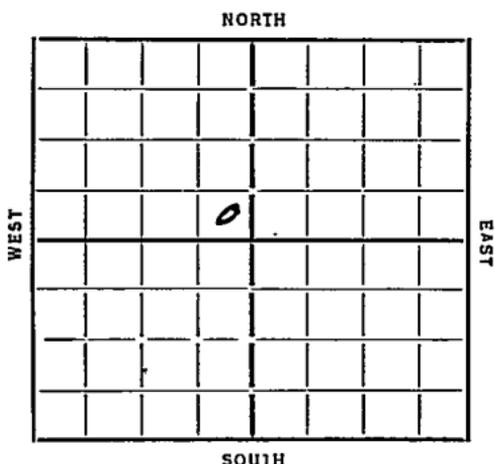

Date	REPORT	EL. 1770
1/9	Moving in	
1/17	Bbls	
1/24	Rigs	
1/31	12" 80	
2/7	Alg 510	12" 101
2/14	" 1800	10" 451
2/21	" 2250	8" 2015
2/28	" 2450	8" 2378 S.G. 2415
3/7	" 2760	
3/14	NC 2845 S.O. 2905	Alg 2932
3/21	Topped Siliceous lime	3177
	TD 3178	Hole full oil in
	8 1/2 hrs	Run 7" 3176 (2 days)
3/28	—	
4/4	TD 3179	Tubing
4/11	Pump 117	Bbls 1 1/2 hrs.
4/17	Siliceous 3177	TD 3179
	P 832	Bbls 1 1/2 hrs Natural
COMPLETED		

Edwards
 Map No. 45 Sec. 26 Twp. 17 R. 9W
 Well No. 1-Teubner
Cartevetal Company

Contractor

FIRST REPORTS.

SECTION PLAT

..... Ft. from N. Line
440 Ft. from S. Line
440 Ft. from E. Line
 Ft. from W. Line

	0		

Location.....
 Rig up.....
 Drilling and Remarks:

Moving in

RECORD

Cased..... in., ft.
 Sand.....
 Gas.....
 Oil.....
 Total Depth.....

PRODUCTION

1st 24 hrs. Nat.....
 1st 24 hrs. after shot.....
 Gas..... Cu. Ft.
 Dry Hole.....
 Abandoned.....

Date

1-9-35 192

ORVAL MANNSCHRECK

Scout

Map No. 45 Sec. 26 Twp. 17 R. 9W

Well No. 1-Teubner

Carter oil co etal Company

Contractor

COMPLETED

SECTION PLAT

		0	

.....Ft. from N. Line

440 Ft. from S. Line

440 Ft. from E. Line

.....Ft. from W. Line

RECORD

Location.....

Rig up.....

Drilling and Remarks:

Cased..... in., ft.

Sand silicious 3177

Gas.....

Oil.....

Total Depth 3179

PRODUCTION

1st 24 hrs. Nat.....

1st 24 hrs. after shot.....

Gas..... Cu. Ft.

Dry Hole.....

Abandoned.....

P. 832 bbls
17 1/2 hrs
Natural

Date

ORVAL MANNSCHECK

4-17-35 192.....

Scout