



Ellsworth

Map No. **KANSAS** Sec. 26 Twp. 17 R. 9<sup>w</sup>

Well No. 3- Teubner Farm  
Carter et al Company


\_\_\_\_\_ Ft. from N. Line

440 Ft. from S. Line

\_\_\_\_\_ Ft. from E. Line

1320 Ft. from W. Line

Elev. 1766

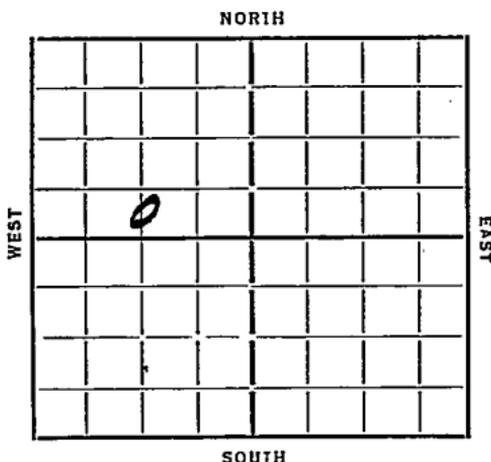

Date 1935 REPORT

8/14 Location  
 8/22 Log  
 8/29 112" 125 woc  
 9/6 114 430  
 10/3 26 76 WR 8"  
 10/10 KC 2843  
 408 w 2944  
 114 3075  
 10/30 Sil 3174  
 TD 3182 1/2  
 1371. 136w.

COMPLETED


*Telsworth*  
 Map No. *45* Sec. *26* Twp. *17* R. *9W*  
 Well No. *3-Teubner*  
*Carter et al* Company

Contractor

FIRST REPORT

SECTION PLAT'

..... Ft. from N. Line  
*440* Ft. from S. Line  
 ..... Ft. from E. Line  
*1320* Ft. from W. Line

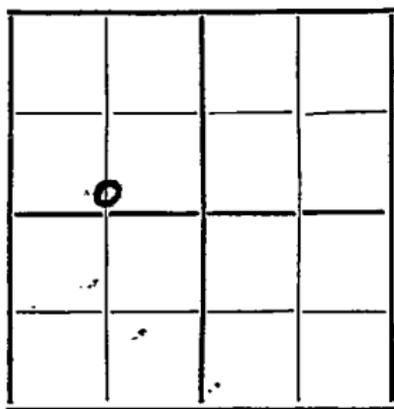

FIRST REPORT

Location  .....  
 Rig up .....  
 Drilling and Remarks:  
 .....

RECORD

Cased..... in., ..... ft.  
 Sand.....  
 Gas.....  
 Oil.....  
 Total Depth.....

PRODUCTION

1st 24 hrs. Nat.....  
 1st 24 hrs. after shot.....  
 Gas..... Cu. Ft.  
 Dry Hole.....  
 Abandoned.....

Date  
*8-14-35* 192.....

ORVAL MANNSCHRECK  
 ..... Scout

Map No. 45 Sec. 26 Twp. 17 R. 9W

Well No. 3-Teubner

Carter et al Company

Contractor

COMPLETED

SECTION PLAT

	0		

..... Ft. from N. Line

440 Ft. from S. Line

..... Ft. from E. Line

1320 Ft. from W. Line

Location.....

Rig up.....

Drilling and Remarks:

1371  
ppb

RECORD

Cased..... in., ..... ft.

Sand nil 3174

Gas.....

Oil.....

Total Depth 3182 1/2

PRODUCTION

1st 24 hrs. Nat.....

1st 24 hrs. after shot.....

Gas..... Cu. Ft.

Dry Hole.....

Abandoned.....

Date

ORVAL MANNSCHECK

10-30-35 192.....

Scout