


Ellsworth

Map No. KANSAS Sec. 26 Twp. 17 R. 9W

Well No. 2 - Ogden Farm
Carter et al Company

440 Ft. from N. Line
Ft. from S. Line
1320 Ft. from E. Line
Ft. from W. Line

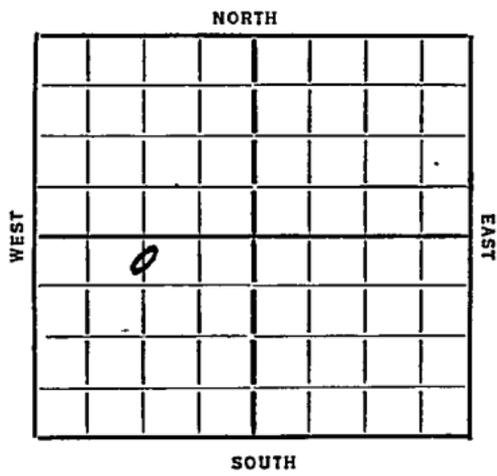

Elev. 1761

Date	REPORT
1935	
10/30	Location
11/7	R N Cab. Tools
11/14	TD 130 Runy 12"
11/21	10" 420
10/29	Deg 1450
12/6	deg 1790
12/13	
12/19	TD 1850 WR 8"
12/26	Deg 1985
1/6/36	" 2230
1/19	" 2640 deg. 2412-20
1/17	" 2868
1/24	TIC @ 2850 WR 8" 3150
1/31	T Lib 3167 41' 7" liner 3168
	TD 3170 HFO Test
2/7	pumped 1093 18 hrs
	Will retest
2/14	Retesting
2/21	—
2/28	To pump.
3/6	—

(OVER)

3/18 Ail 3167
TD 3170
1431 Bbls.

COMPLETED

Map No. 45 Sec. 26 Twp. 17 R. 9W

Well No. 2- Ogden

Carter et al. Company

Contractor

FIRST REPORTS


SECTION PLAT

440 Ft. from N. Line

..... Ft. from S. Line

1320 Ft. from E. Line

..... Ft. from W. Line

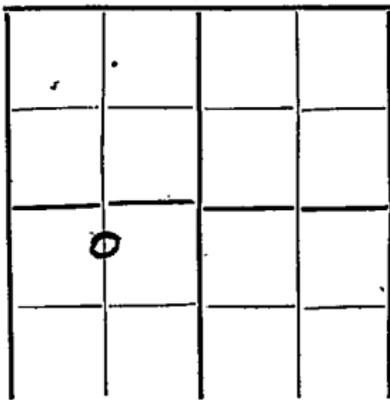

Location

Rig up

Drilling and Remarks:

RECORD

Cased..... in., ft.

Sand.....

Gas.....

Oil.....

Total Depth.....

PRODUCTION

1st 24 hrs. Nat.....

1st 24 hrs. after shot.....

Gas..... Cu. Ft.

Dry Hole.....

Abandoned.....

Date

10-30-35 192

ORVAL MANSCHERCK
Scout

no wave

44
44

Returned	<i>MM</i>
Cards	<i>MM</i>
Tracing	<i>MM</i>
France Map	<i>c</i>
Scarborough Map	<i>c</i>
Moody Map	<i>c</i>
Scarborough Flat Book	
Moody Flat Book	

1-1-11

Map No. 45 Sec. 26 Twp. 17 R. 9W

Well No. 2 - Ogden

Carter et al Company

Contractor

COMPLETED

SECTION PLAT

440 Ft. from N. Line

..... Ft. from S. Line

1320 Ft. from E. Line

..... Ft. from W. Line

	0		

Location.....

Rig up.....

Drilling and Remarks:

RECORD

Cased..... in., ft.

Sand Sil. 3167

Gas.....

Oil.....

Total Depth..... 3170

PRODUCTION

1st 24 hrs. Nat.....

1st 24 hrs. after shot.....

Gas..... Cu. Ft.

Dry Hole.....

Abandoned.....

1431 bbls

Date

MAR 18 1936

ORVAL MANNSCHRECK

192.....

Scout

[Large handwritten scribbles and lines across the top of the page]

Returned	<i>[Signature]</i>
