


Map No. **KANSAS** Sec. 26 Twp. 17 R. 9 W
 Well No. 25 Ellsworth Hubb Carters etc Farm _____ Company _____

NORTH

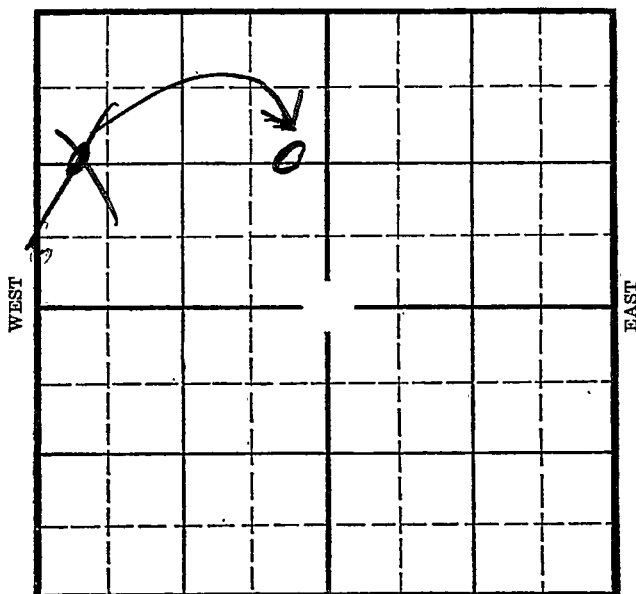

SOUTH

Location _____

Drilling Remarks _____

Rig Up _____

Drilling Remarks _____

RECORD

Cased _____ in. _____ ft.

Sand _____

Gas _____

Oil _____

Total Depth _____

PRODUCTION

1st 24 hrs. Nat. _____

1st 24 hrs. after shot _____


Gas _____ cu. ft. _____

Dry Hole _____

Abandoned _____

Cartier Inc Company

Ft. from W. Line

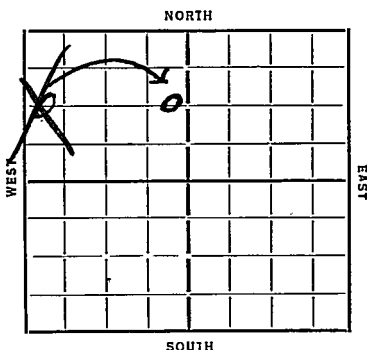

Date:

REPORT

7/17	Ponds.	18 1/2 114
8/8	alg 1210	10 405
8/15	alg 1985	
8/22	alg 1985	
8/29	alg 1999	
10/3	Lil 3181-86 3100' 1 hr.	
10/8	Lil 3181	
	T7 3186	
	1596 Bblu	

~~COMPLETED~~

Map No. 48 Sec. 26 Twp. 17 R. 9WWell No. 2-Tenber
Carter et al Company

Contractor

COMPLETED

SECTION PLAT

0			

Ft. from N. Line

1320 Ft. from S. Line

Ft. from E. Line

330 Ft. from W. Line

Location

Rig up

Drilling and Remarks:

1596
pps

RECORD

Cased in ft.Sand 3181

Gas

Oil

Total Depth 3186

-PRODUCTION

1st 24 hrs. Nat.

1st 24 hrs. after shot

Gas Cu. Ft.

Dry Hole

Abandoned

Date

10-8-35 192

ORVAL MANNSCHRECK

Scout

Map No. 45 Sec. 26 Twp. 17 R. 9W

Well No. 2 - Treubner

Carter et al Company

Contractor

SHOT REPORTS

Ft. from N. Line

1320 Ft. from S. Line

330 Ft. from E. Line

Ft. from W. Line

SECTION PLAT

0			

Location

Rig up

Drilling and Remarks:

ponds

RECORD

Cased in., ft.

Sand

Gas

Oil

Total Depth

PRODUCTION

1st 24 hrs. Nat.

1st 24 hrs. after shot

Gas Cu. Ft.

Dry Hole

Abandoned

Date

ORVAL MANNSCHRECK

7-17-35 192

Scout

Map No. 45 Sec. 26 Twp. 19 R. 9W

Well No. 2 Teubner

Ooster et al Company

Contractor

SECTION PLAT

1820 Ft. from N. Line

_____ Ft. from S. Line

330 Ft. from E. Line

_____ Ft. from W. Line

COMPLETED WELL

CORRECTION

	0		

Location _____

Rig up _____

Drilling and Remarks:

*Reported
CWL Ver.*

RECORD

Cased _____ in., _____ ft.

Sand _____

Gas _____

Oil _____

Total Depth _____

PRODUCTION

1st 24 hrs. Nat. _____

1st 24 hrs. after shot _____

Gas _____ Cu. Ft.

Dry Hole _____

Abandoned _____

Date

8/22/36 19 St Louis Scout