


Ellsworth

Map No. KANSAS Sec. 26 Twp. 17 R. 9 W

Carter Oil Co Company

NORTH

3

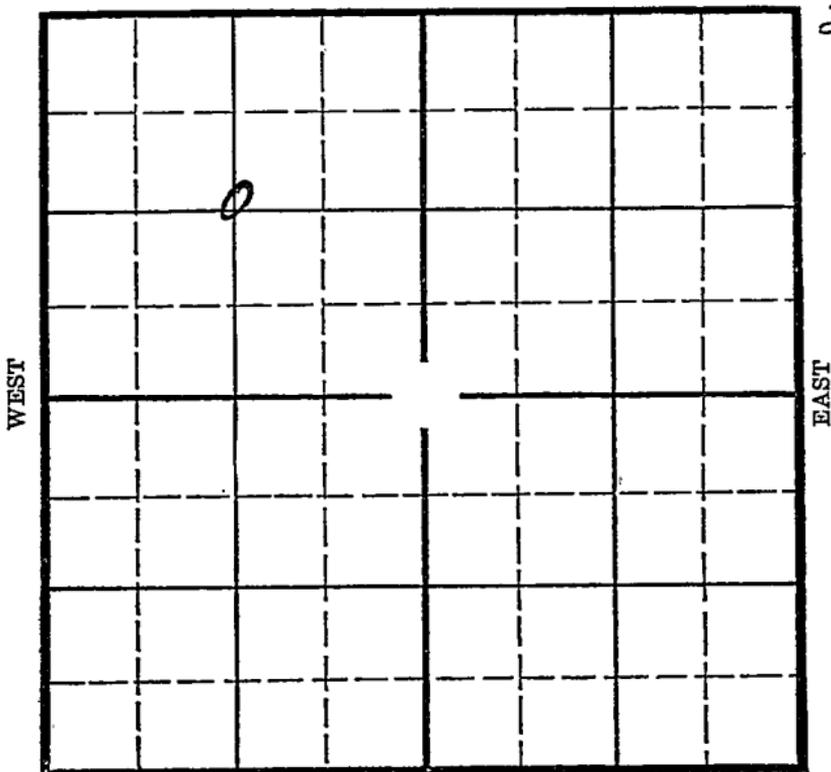

SOUTH

Location _____

Drilling Remarks _____

Rig Up _____

Drilling Remarks _____

RECORD

Cased _____ in. _____ ft.

Sand _____

Gas _____

Oil _____

Total Depth _____

PRODUCTION

1st 24 hrs. Nat. _____

1st 24 hrs. after shot _____

Gas _____ cu. ft.

Dry Hole _____


Abandoned _____

Ellsworth

Map No. KANSAS Sec. 26 Twp. 17 R. 9W

Well No. 4 - Teubner Farm
Carter Oil etab Company

1320 Ft. from N. Line
____ Ft. from S. Line
____ Ft. from E. Line
1320 Ft. from W. Line

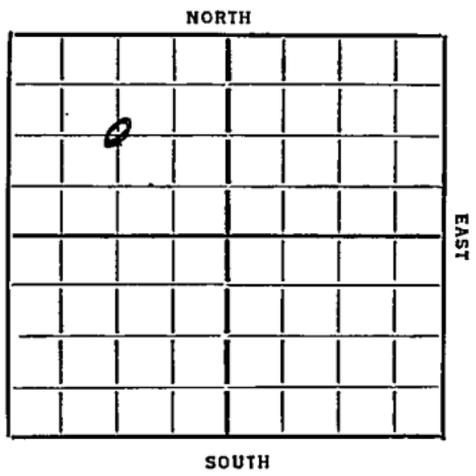

Elev. 1765

REPORT

Date	Report
1935	
12/27	Rot Rig
1/2/36	Ru
1/10	Dlg 1637 12" 150
1/17	" 3164
1/24	T Sil 3170 TD 3172
	8" 3172 WOC
1/31	TD 3176 HFO
	On pot
2/7	pumped, 877 24 hrs. down 4 hrs. Will reset
2/14	Setting pumping unit
2/21	— 2/28 — 3/6 —
2/21	Sil 3170
	TD 3176
	1072 Bbls Oil

COMPLETED

KANSAS

Edwards

Map No. 45 Sec. 26 Twp. 17 R. 9W


Well No. 4 - Teubner
Carter oil etal Company

Contractor

FIRST RECORD

SECTION PLAT

1320 Ft. from N. Line
 Ft. from S. Line
 Ft. from E. Line
1320 Ft. from W. Line

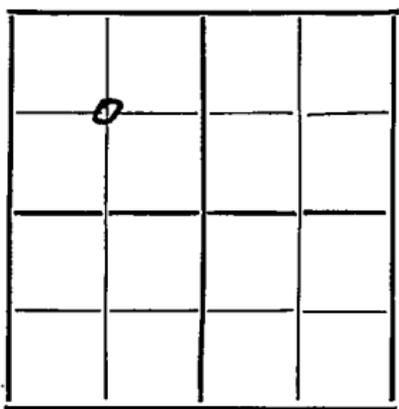

Location.....

Rig up.....

Drilling and Remarks:

Pat Rig

RECORD

Cased.....in.,ft.
 Sand.....
 Gas.....
 Oil.....
 Total Depth.....

PRODUCTION

1st 24 hrs. Nat.....
 1st 24 hrs. after shot.....
 Gas.....Cu. Ft.
 Dry Hole.....
 Abandoned.....

Date

12-23-35 192.....

ORVAL MANNSCHRECK

Scout

Edenworth

Map No. *45* Sec. *26* Twp. *17* R. *9W*

Well No. *4 - Teubner*

Carter et al Company

Contractor

COMPLETE


SECTION PLAT

1320 Ft. from N. Line

..... Ft. from S. Line

..... Ft. from E. Line

1320 Ft. from W. Line

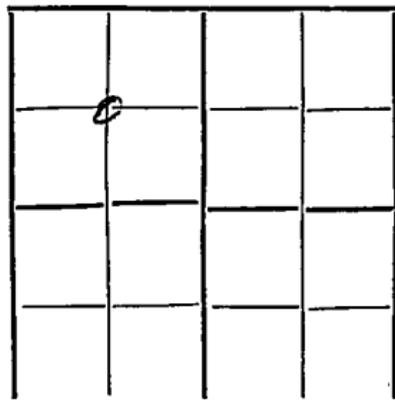

Location.....

Rig up.....

Drilling and Remarks:

1072 bbls

RECORD

Cased..... in. ft.

Sand *Sil 3170*

Gas.....

Oil.....

Total Depth *3176*

PRODUCTION

1st 24 hrs. Nat.....

1st 24 hrs. after shot.....

Gas..... Cu. Ft.

Dry Hole.....

Abandoned.....

Date

3-11-36 192

ORVAL MANNSCHRECK

Scout