


Section 26 Township 17 Range 9-W

Well Number #7 ~~#6~~-Teubner

Company Carter et al

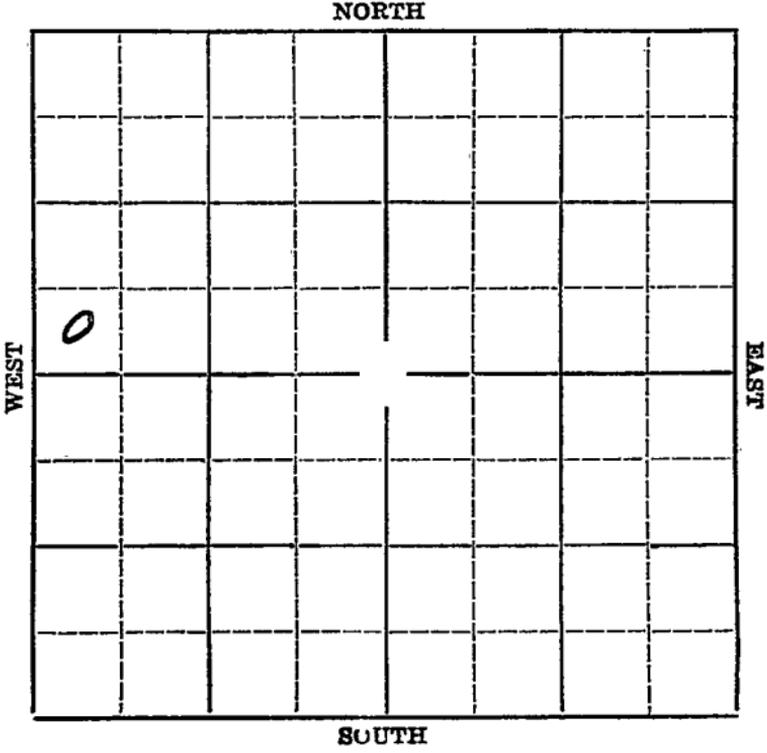

Map No. KANSAS Sec. 26 Twp. 17 R. 9W

Well No. ~~#7~~ Teubner Farm

Carter et al Company


_____ Ft. from N. Line

330' Ft. from S. Line

_____ Ft. from E. Line

330' Ft. from W. Line

Elev. 1765

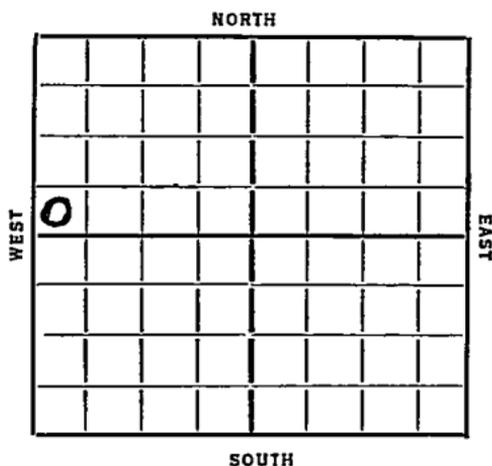

Date	REPORT
1936	
7/1	Location.
7/9	Rig on ground.
7/16	7" @ 206'. Waiting on cement.
7/23	Drilg. 2230'.
7/30	Siliceous 3158'. Run 7" @ 3162'.
8/6	--
8/13	T.D. 3174'. Pump 180' oil in 16 hrs
	1000 gallons of acid. No test.
8/20	TD 3172' hole full of oil.
8/26/36	-Sil. 3158'.
	T.D. 3177'.
	1000 gallons of acid.
	Potential 1127 bbls of oil and
	20 bbls of water.
	COMPLETED

Form 26 1M Bks. 2328
Elsworth

Map No. 45 Sec. 26 Twp. 17 R. 9W

Well No. 6 *Teutner*

Carter et al Company

Contractor

SECTION PLAT

0			

_____ Ft. from N. Line

330 Ft. from S. Line

_____ Ft. from E. Line

330 Ft. from W. Line

FIRST REPORT

Location ✓

Rig up _____

Drilling and Remarks:

[Faint handwritten notes and markings]

RECORD

Cased _____ in., _____ ft.

Sand _____

Gas _____

Oil _____

Total Depth _____

PRODUCTION

1st 24 hrs. Nat. _____

1st 24 hrs. after shot _____

Gas _____ Cu. Ft.

Dry Hole _____

Abandoned _____

Date

III

19

Scout

Map No. 45 Sec. 26 Twp. 17 R. 9W

Well No. 7 Neuberger

Carted Oil Company

Contractor

SECTION PLAT

0			

_____ Ft. from N. Line

330 Ft. from S. Line

_____ Ft. from E. Line

330 Ft. from W. Line

CORRECTION

Location _____

Rig up _____

Drilling and Remarks:

*Reported as
No 6*

RECORD

Cased _____ in., _____ ft.

Sand _____

Gas _____

Oil _____

Total Depth _____

PRODUCTION

1st 24 hrs. Nat. _____

1st 24 hrs. after shot _____

Gas _____ Cu. Ft.

Dry Hole _____

Abandoned _____

Date

JUL 8 1936

19

S J. LEWIS

Scout

KANSAS

Map No. 45 Sec. 26 Twp. 17 R. 9W

Well No. 7 Thompson

Carter & Dal Company

Contractor

SECTION PLAT

_____ Ft. from N. Line

330 Ft. from S. Line

_____ Ft. from E. Line

330 Ft. from W. Line

COMPLETED

Location _____

Rig up _____

Drilling and Remarks:

Sil 3158
1000 acid
P.S. 1127 oil
20 water

RECORD

Cased _____ in., _____ ft.

Sand _____

Gas _____

Oil _____

Total Depth 23177

PRODUCTION

1st 24 hrs. Nat. _____

1st 24 hrs. after shot _____

Gas _____ Cu. Ft.

Dry Hole _____

Abandoned _____

Date

AUG 26 1936 19

S. J. LEWIS Scout