


Section 26 Township 17 Range 9-W

Well Number #8-Teubner

Company Carter et al

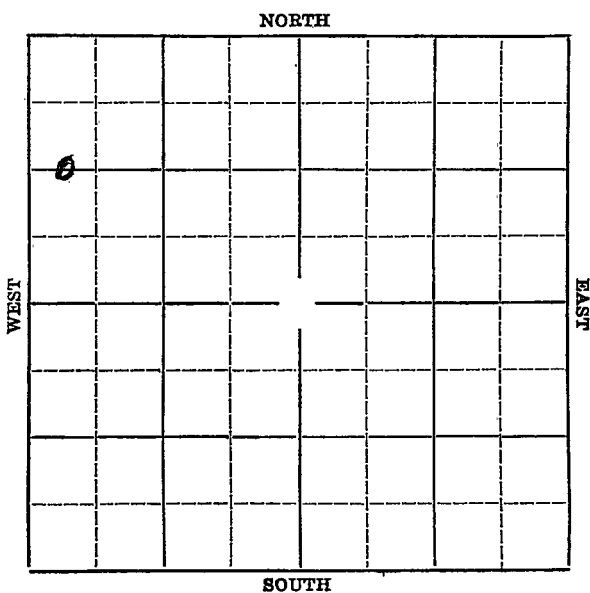

Sec. 26 Twp. 17 R. 9W

Well No. #8 Teubner Farm

Carter et al Company


NORTH

1320' Ft. from N. Line

\_\_\_\_\_ Ft. from S. Line

\_\_\_\_\_ Ft. from E. Line

440' Ft. from W. Line

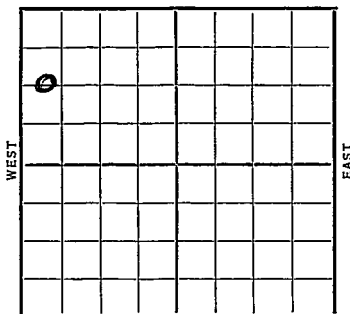

Elev. 1768

Date 1936

REPORT

8/19 Rig.

8/27 10" @ 213'. TD 216'. WOC.

9/3 Drlg. 2841'.

9/10 Siliceous 3169'. 7" @ 3169'.

Rigging up standard tools.

9/18 T.D. 3188'. Pump 130 bbls of oil in 24 hours.

9/24 1000 gallons of acid. Pump 221 bbls of oil in 24 hours.

10/1 T.D. 3190'. Testing.

10/8 Pump 219 bbls in 13 hours.

10/14/36-Sil. 3169'.

T.D. 3190'.

Shot 10 qts.

1000 gallons of acid.

Potential 455 bbls of oil.

COMPLETED

Map No. 45 Sec. 26 Twp. 17 R. 9W

Well No. J Tenkner

Carter & Co. Company

Contractor

SECTION PLAT

0			

1320 Ft. from N. Line

\_\_\_\_\_ Ft. from S. Line

\_\_\_\_\_ Ft. from E. Line

440 Ft. from W. Line

FIRST REPORT

Location \_\_\_\_\_

Rig up \_\_\_\_\_

Drilling and Remarks:

*Rig*

RECORD

Cased \_\_\_\_\_ in., \_\_\_\_\_ ft.

Sand \_\_\_\_\_

Gas \_\_\_\_\_

Oil \_\_\_\_\_

Total Depth \_\_\_\_\_

PRODUCTION

1st 24 hrs. Nat. \_\_\_\_\_

1st 24 hrs. after shot \_\_\_\_\_

Gas \_\_\_\_\_ Cu. Ft.

Dry Hole \_\_\_\_\_

Abandoned \_\_\_\_\_

Date

5/19/36 19

*J. Lewis* Scout

KANSAS

Form 26-1M Bks. 2-23

Map No. 45 Sec. 26 Twp. 17 R. 9W

Well No. 5 Teutonia

Carsted & Co Company

Contractor

SECTION PLAT


1820 Ft. from N. Line

\_\_\_\_\_ Ft. from S. Line

\_\_\_\_\_ Ft. from E. Line

440 Ft. from W. Line

COMPLETED

Location \_\_\_\_\_

Rig up \_\_\_\_\_

Drilling and Remarks:

Sil 3169  
Shd 8109ft.  
1000 acid  
P 8455

RECORD

Cased \_\_\_\_\_ in., \_\_\_\_\_ ft.

Sand \_\_\_\_\_

Gas \_\_\_\_\_

Oil \_\_\_\_\_

Total Depth 3190

PRODUCTION

1st 24 hrs. Nat. \_\_\_\_\_

1st 24 hrs. after shot \_\_\_\_\_

Gas \_\_\_\_\_ Cu. Ft.

Dry Hole \_\_\_\_\_

Abandoned \_\_\_\_\_

Date

OCT 14 1936

S. J. LEWIS Scout