



Ellsworth

Map No. KANSAS Sec. 26 Twp. 17 R. 9W


Well No. 1- Williams Farm  
Carter et al. Company

\_\_\_\_\_ Ft. from N. Line

440 Ft. from S. Line

\_\_\_\_\_ Ft. from E. Line

440 Ft. from W. Line

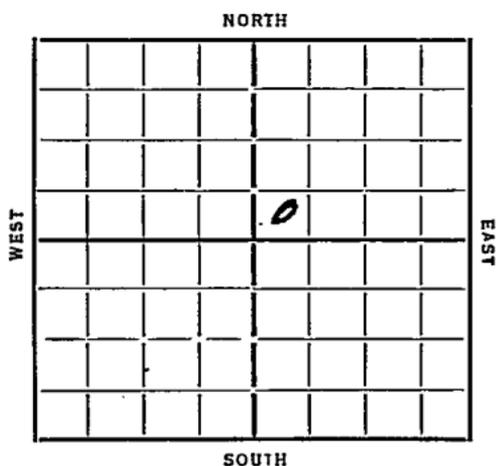

Date

REPORT

1935  
4/24 Material  
5/2 Row  
5/9 13 1/2 in 12 1/2"  
5/16 Dlg 715 10" 440  
5/23 " 1680  
5/29 " 2255  
6/6 —  
6/13 CO 2255  
6/20 Dlg 2300  
6/28 " 3010  
7/3 " 3105  
7/11 7" 3197 Oil 3202 1/2  
T 7 3205 1/2 2700 Oil  
400 W.  
7/17 Oil 3202 1/2 T 7 3205 1/2  
PB 3204  
98 Oil  
98 Water

COMPLETED

Map No. 45 Sec. 26 Twp. 17 R. 9W

Well No. 1-Williams

Carter et al Company

Contractor

**FIRST REPORT**

**SECTION PLAT**

.....Ft. from N. Line

440 Ft. from S. Line

.....Ft. from E. Line

440 Ft. from W. Line

		0	

Location.....

Rig up.....

Drilling and Remarks:

*Material*

**RECORD**

Cased.....in., .....ft.

Sand.....

Gas.....

Oil.....

Total Depth.....

**PRODUCTION**

1st 24 hrs. Nat.....

1st 24 hrs. after shot.....

Gas.....Cu. Ft.

Dry Hole.....

Abandoned.....

Date

4-24-35 192

**ORVAL MANNSCHRECK**

Scout

*Edwards*

Map No. *45* Sec. *26* Twp. *17* R. *9W*

Well No. *1-Williams*

*Carter et al* Company

Contractor

NOT RECORDED

SECTION PLAT

		0	

..... Ft. from N. Line

*440* Ft. from S. Line

..... Ft. from E. Line

*440* Ft. from W. Line

RECORD

Location.....

Cased *1 1/2* in., ..... ft.

Rig up.....

Sand *sl 320 1/2*

Drilling and Remarks:

Gas.....

*PB 3204*

Oil.....

Total Depth *3205 1/2*

PRODUCTION

*98 oil  
98 water*

1st 24 hrs. Nat.....

1st 24 hrs. after shot.....

Gas..... Cu. Ft.

Dry Hole.....

Abandoned.....

Date

*OPVAL MANNSCRECK*

*7-17-35* 192.....

Scout