

Map No. KANSAS

Sec. 26

Twp. 17

R. 9^w

Well No. 2-Williams

Farm

Carter et al

Company


_____ Ft. from N. Line

1320 Ft. from S. Line

_____ Ft. from E. Line

330 Ft. from W. Line

Elev. 1775

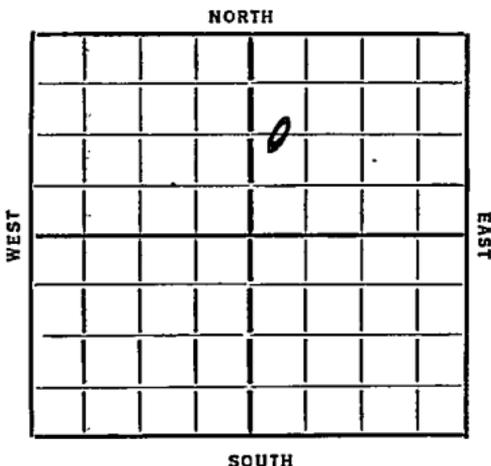

Date	REPORT
<u>1935</u>	
<u>10/30</u>	<u>Cellar</u>
<u>11/7</u>	<u>Ru</u>
<u>11/14</u>	<u>—</u>
<u>11/21</u>	<u>Dly 420</u>
<u>11/29</u>	<u>" 1460 10" 435</u>
<u>12/6</u>	<u>" 2085</u>
<u>12/13</u>	<u>" 2404 8" 2200</u>
<u>12/19</u>	<u>" 2668</u>
<u>12/26</u>	<u>TD 2858 lowering 8" pipe</u>
<u>12/36</u>	<u>TKC 2848</u>
	<u>8" 2858 Dly 2870</u>
<u>1/10</u>	<u>Dly 3130</u>
<u>1/17</u>	<u>8" 3166 Top Sil 3195</u>
	<u>7" liner at 3195 TD 3198</u>
	<u>200' OIH Coring</u>
<u>1/24</u>	<u>TD 3200, 2200' OIH</u>
	<u>pumped 184 Oil 150 wtu</u>
	<u>With PB.</u>
<u>1/31</u>	<u>PB 8" & acidizing</u>
<u>2/7</u>	<u>PB 3196 To acidize</u>
<u>2/14</u>	<u>SPO.</u>
<u>2/21</u>	<u>Pulled liner & CO</u>

OVER

2/28 117 1/2 Oil & 65 wtr 16 ~~lb~~

3/6 —

3/13 On potential

3/25 Oil 3166

TD 3196

70 Oil

31 Water

COMPLETED

KANSAS

Ellsworth
Map No. *45* Sec. *26* Twp. *17* R. *9W*

Well No. *2-Williams*
Carter et al Company

Contractor

FIRST REPORTS


SECTION PLAT

.....Ft. from N. Line

1320 Ft. from S. Line

.....Ft. from E. Line

330 Ft. from W. Line

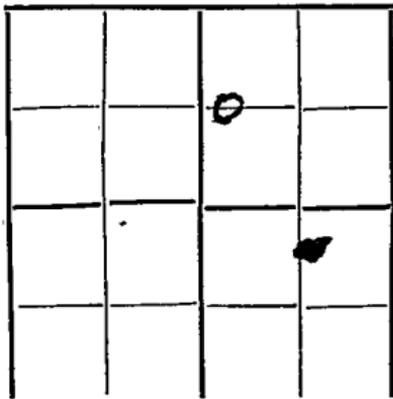

Location.....

Rig up.....

Drilling and Remarks:

cellar

RECORD

Cased.....in.,ft.

Sand.....

Gas.....

Oil.....

Total Depth.....

PRODUCTION

1st 24 hrs. Nat.....

1st 24 hrs. after shot.....


Gas.....Cu. Ft.

Dry Hole.....

Abandoned.....

Date

10-30-35 192 *ORVAL MANNSCHPECK* Scout

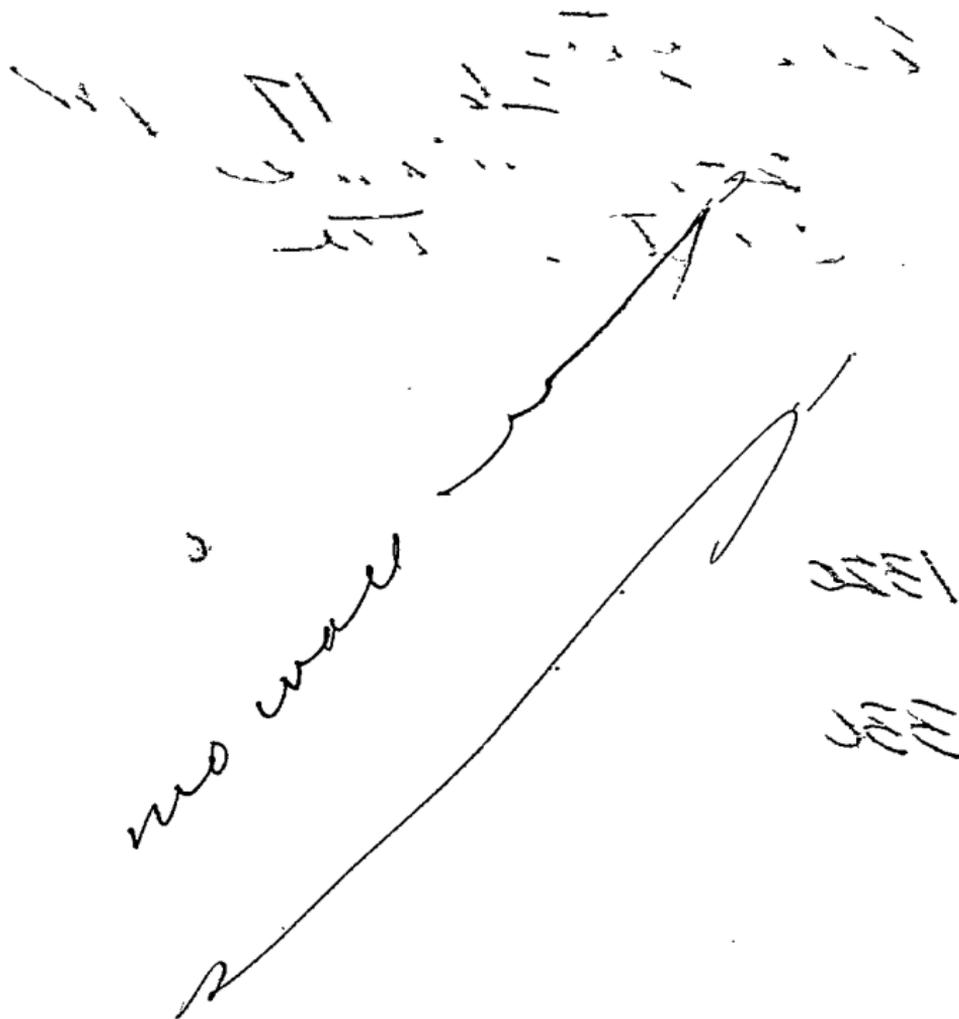

no wall

11/11
11/11

<i>John</i>	
<i>John</i>	
Scarborough	
Moody Map	
Scarborough Flat Book	
Moody Plat Book	

11/11 11/11


Map No. 45 Sec. 26 Twp. 17 R. 9

Well No. 2 Williams

Carter Oil Company

Contractor

SECTION PLAT

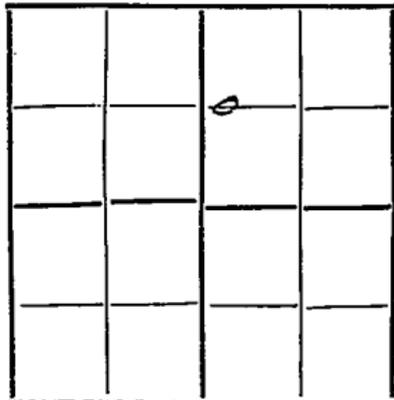

..... Ft. from N. Line

1320 Ft. from S. Line

..... Ft. from E. Line

830 Ft. from W. Line

COMPLETE

Location.....

Rig up.....

Drilling and Remarks:

Stop Oil 3166

70 oil
81 water

RECORD

Cased..... in., ft.

Sand.....

Gas.....

Oil.....

Total Depth... 3196

PRODUCTION

1st 24 hrs. Nat.....

1st 24 hrs. after shot.....

Gas..... Cu. Ft.


Dry Hole.....

Abandoned.....

Date

3/25/36 192.....

S. J. LEWIS Scout

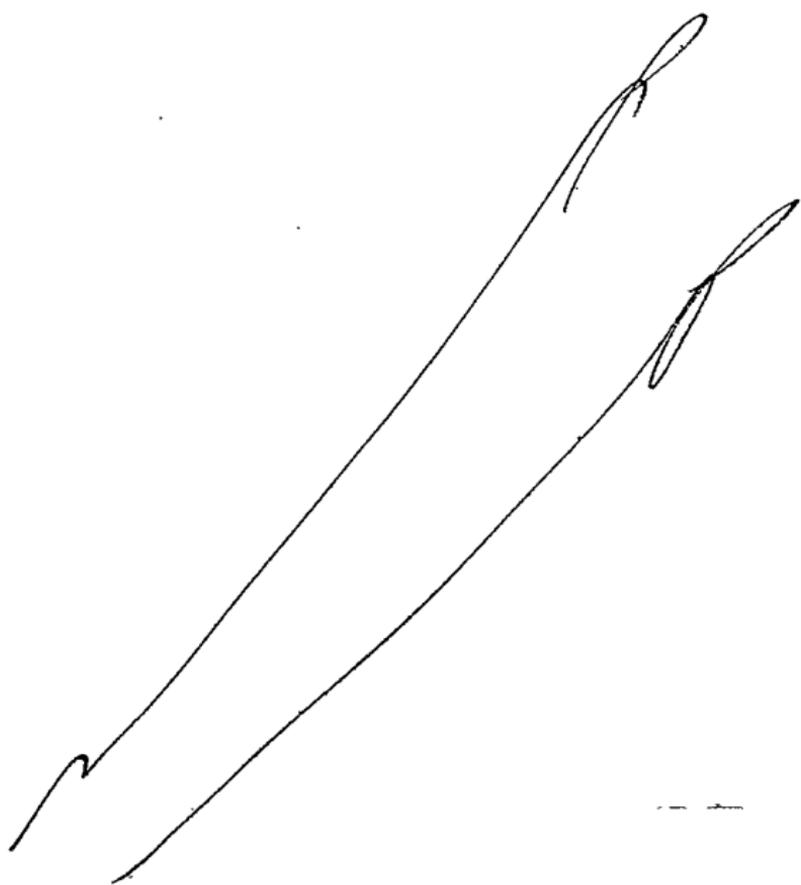

Returned	<i>[Signature]</i>
Cards	<i>[Signature]</i>
Tracing	<i>[Signature]</i>
France Map	<i>[Signature]</i>
Scarborough Map	<i>[Signature]</i>
Moody Map	<i>[Signature]</i>
Scarborough Plat Book	<i>[Signature]</i>
Moody Plat Book	<i>[Signature]</i>