


Section 26 Township 17 Range 8W

Well No. #2 Gray

Company Eldorado Refg.

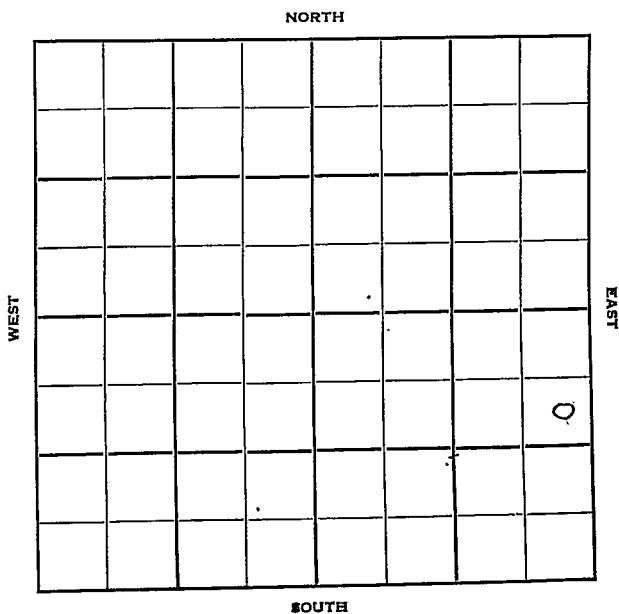

Ellsworth

Sec. 26 Twp. 17 R. 8 W ✓

Well No. # 2 Gray Farm

El Dorado Refg. Company

Contractor


990 Ft. from N. Line

_____ Ft. from S. Line

330 Ft. from E. Line

_____ Ft. from W. Line

SE NE SE

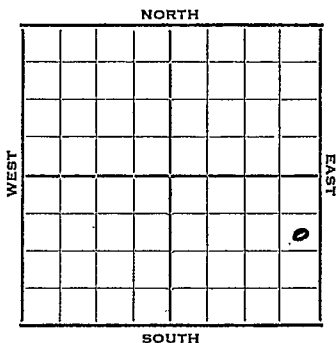

1952

Elev. 1730'

REPORT

5/7 Spud 4-28-52
8" @ 305' Heeb 2630' Br. lime 2765'
Lans. 2780'
DST 2801-19, open $\frac{1}{2}$ hr, rec 60' GCM
Drlg 3028' 1080#

5/14 V 3179 Simp 3224
Arb. 3274 RTD 3283
SO 3276-79 5" @ 3283 CO

5/21 DP DD 3286' S/1 BOPH DD 3289 TD
3000' fill up oil 2 hrs. S/45 BOPH
for 3 hrs. tub & rods.

5/28 POP

6/4 Spud 4-28-52 Oil Well TD 3289
8" @ 305 Heeb. 2630 Lans. 2780
DST 2801-19 opn $\frac{1}{2}$ hr. Rec. 60' gcm
Viola 3179 Simp 3224 Arb. 3274
TD 3283 5" @ 3283 SO 3276-79
DD 3286 S/1 boph DD 3289 FU 3000'
oil 2 hr. S/45 boph Comp. 3097 bopd

COMPLETED

