


Section 26 Township 17 Range 8W

Well No. #4 Gray "A"

Company Grant Oil & Carey Drlg.

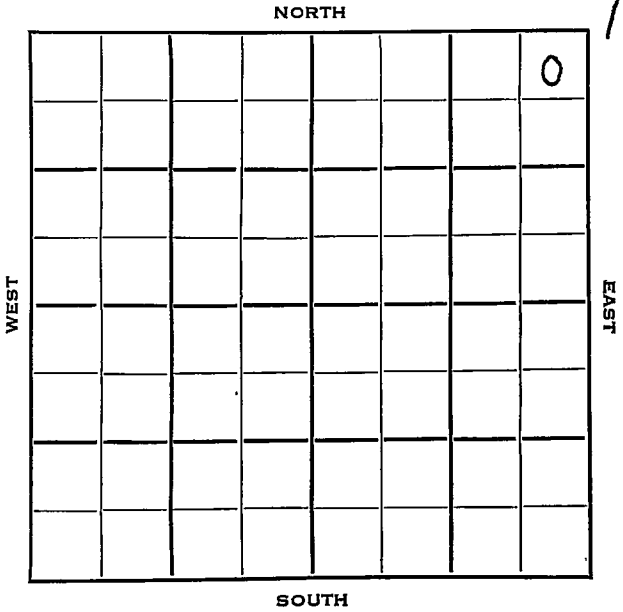

Sec. 26 Twp. 17 R. 8 W

Well No. # 4 Gray "A" Farm

Grant Oil & Carey Drlg. Company

Carey Drlg. Contractor

Maes Pool


330 Ft. from N. Line

_____ Ft. from S. Line

330 Ft. from E. Line

_____ Ft. from W. Line

NE NE NE

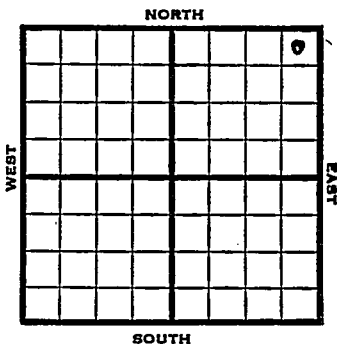

1953

Elev. 1730' REPORT

5/6
5/21

Location
10" @ 283 Anhy 420
Drlg. 3010'

5/28
6/3

N.R.
Spud 5-8-53 Oil well TD 3295
10" @ 283 Anhy 420 Heeb 2644
Br line 2769 KC 2792
DST 2876-88 open 1 1/2 hr. rec 60' GCM
120' wtr. 960# Viola 3199'
Simp 3238 Arb. 3291 TD 3294
7" @ 3 293, DD 3295 S/12 BOPH 250A
Comp. 2866 BOPD 3% wtr.

COMPLETED

County Ellsworth State Kansas
 Sec. 26 (Blk. 17) (Sur. 8W) (Twp.) (Rge.) Map No.
 Operator Grant Oil & Carey Drlg.
 Well No. 4 Farm Gray "A"
 Elev. 1730 Location NE NE NE

					0

330 Ft. From N Line NE

330 Ft. From E Line Quarter

1st. Report

Completion JUN 3 1953Remarks Maes PoolCarey Drlg. - Contr.Spudding Date 5-8-53Drlg. Data Oil well TD 329510" @ 283 Anhy 420 Heeb. 2644Br. lime 2769 KC 2792 DST 2876-88open $1\frac{1}{2}$ hr. Rec. 60' gcm 120' wtr.960# Viola 3199 Simp. 3238Arb. 3291 TD 3294 7" @ 3293DD 3295 S/ 12 boph 250 AComp. 2866 bopd 3% wtr.

J. G. MCGEHEE