



Sec. 26 Twp. 17 R. 8W

Well No. #2 Maes Farm

E. K. Carey Company

Carey Drlg. Contractor  
Maes Pool

Ft. from N. Line

990


Ft. from S. Line

Ft. from E. Line

990

Ft. from W. Line

NE SW SE

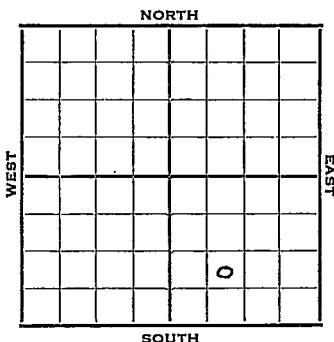

1952 Elev. 1744' REPORT

5/14 Spud 5-10-52  
8" @ 305' WOC

5/21 Anhy 740' Heeb 2659' Br li 2783'  
Lans. 2808'  
Drlg. 3130'

5/28 B KC 3137' V 3231  
Simp. 3276 Arb. 3334  
DST 3335-44, 1/2 hr. 480' oil 60' OCM  
& trace wtr. 920# 15" TD 3344'  
4" @ 3337 RUST

6/11 CO 3345' TD S/7 BOPH & trace wtr.

6/18 NR

6/25 NR

7/2 Spud 5-10-52  
Oil Well TD 3345 8" @ 305  
Anhy 470 Heeb. 2659  
Br Li 2783 Lans. 2808  
B KC 3137 Viola 3231  
Simp. 3276 Arb. 3334  
DST 3335-44 open 1/2 hr. rec. 480' oil  
60' ocm TD 3344 4" @ 3337  
CO to 3345 S/ 7 boph Comp. 219 bopd  
24% wtr.

**COMPLETED**



