


Section 26 Township 17 Range 8W

Well No. #2 Gray (A)

Company Grant Oil & E. K. Carey

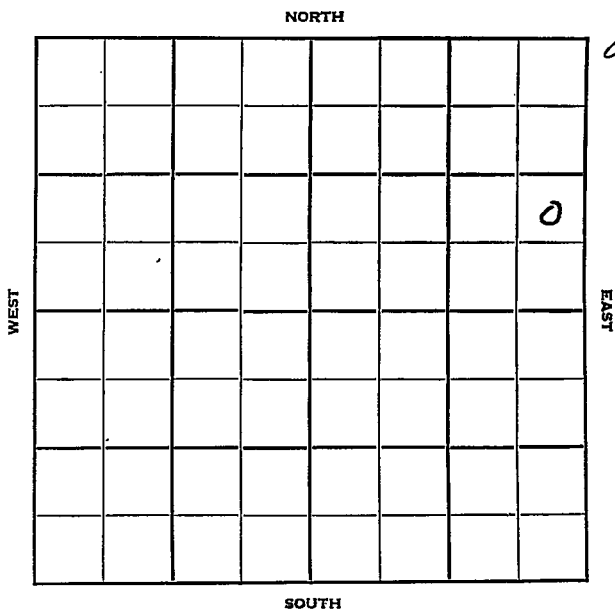

Sec. 26 Twp. 17 R. 8W

Well No. #2 Gray (A) Farm

Grant Oil & E.K. Carey Company

E. K. Carey - Contr. Contractor


Ft. from N. Line

990' Ft. from S. Line

330' Ft. from E. Line

Ft. from W. Line

NE SE NE

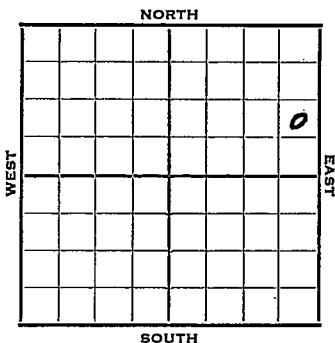

1952 Elev. 1703 REPORT

8/27 Spud 8-20-52
8" @ 282
Drlg.

9/3 Drlg.

9/10 Heeb 2610' Br li 2734' Lans. 2757'
B KC 3084' V 3155' Simp. 3157'
Arb. 3237' RTD 3356' 5" @ 3355'

9/17 Spud 8-20-52
Oil Well TD 3356' 8" @ 282
Heeb. 2610 Br Li 2734
Lans. 2757 B KC 3084
Viola 3155 Simp. 3197
Arb. 3257 TD 3356
5" @ 3355' 48/ 3255-67 S/ 8½ boph
250 A S/ 45 boph Comp. 3000 bopd

COMPLETED

