

Ellsworth

Section 26 Township 17 Range 8 **KANSAS** W
 Well No. # 3 Gray (A)
 Company Grant Oil

NORTH

							0

SOUTH

WEST

EAST

Ellsworth

KANSAS

Sec. 26 Twp. 17 R. 8W

Well No. #3 Gray "A" Farm

Grant Oil Company

Contractor


Maes
990' Ft. from N. Line

Ft. from S. Line

330' Ft. from E. Line

Ft. from W. Line

SE NE NE

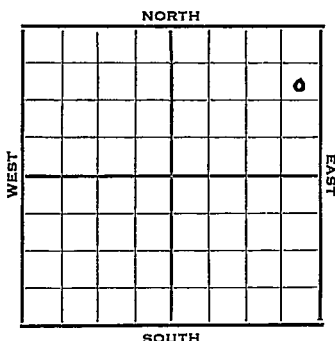

1952 Elev. 1719' REPORT

9/17 Location
9/24 8" @ 279 Drlg. 2255'
10/1 Arb. 3269' RTD 3273' 5" @ ?
Heeb 2626' Br li 2750' KC 2772'
10/8 Spud 9-17-52
Oil Well TD 3281'
8" @ 279'
Heeb. 2626 Br Li 2750
KC 2772 Arb. 3269
TD 3273 5" @ 3271 DD 3281
S/ 35 boph 250 A
Comp. dpetho. pot. 3000 bopd

COMPLETED

County Ellsworth State KansasSec. 26 (Blk. Twp.) 17 (Sur. Rge.) 8W Map No.Operator Grant OilWell No. 3 Farm Gray (A)Elev. _____ Location SE NE NE

990 Ft. From N Line NE330 Ft. From N Line Quarter1st. Report SEP 17 1952

Completion _____

Remarks _____

Spudding Date _____

Drlg. Data _____

MaesLocation

J. G. McGEHEE

County Ellsworth State Kansas

Sec. 26 (Blk. Twp.) 17 (Sur. Rge.) 8W Map No.

Operator Grant Oil

Well No. 3 Farm Gray "A"

Elev.	1719	Location	SE NE NE
-------	------	----------	----------

				0

COMPLETE

990 Ft. From N Line NE

330 Ft. From E Line Quarter

1st. Report

Completion OCT 8 1952

Remarks	Maes Pool
---------	-----------

Spudding Date 9-17-52

Drilg. Data Oil well TD 3281

8" @ 279 Heeb. 2626 Br. lime 2750

KC 2772 Arb. 3269 TD 3273 5" @ 3271

DD 3281 S/ 35 boph 250 A

Comp. depth. pot. 3000 bopd

J. G. McGEHEE