

Sec. 26 Twp. 17 R. 8 W

Well No. # 1 Maes Farm

E. K. Carey Company

Carey Contractor

Wildcat


_____ Ft. from N. Line

330 Ft. from S. Line

_____ Ft. from E. Line

990 Ft. from W. Line

SE SW SE

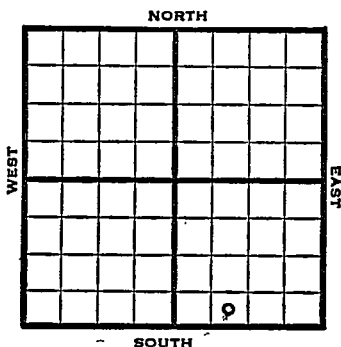

1952

Elev. 1756' REPORT

1/9

Spud 1-5-52

8" @ 305'

Brlg. 1560'

2/6

TD 3357'

5" @ 3354' POP

2/13

No report

2/20

Spud 1-5-52

Oil well TD 3357' 8" @ 305'

DST 2832-50 open 1 hr. rec 225' gas, 30' OCM

KC 2819' B KC 3147' Viola 3237'

Simp. 3281' Arb. 3341'

DST 3341-46 open 1 hr. rec 30' mud


DST 3346-57 open 1/2 hr. rec 1040' oil, 100' SW

TD 3357' 5" @ 3354' CO to 3357'

S/14 BOPH 15% water.

Comp. 478 BOPD 8% water.

COMPLETED

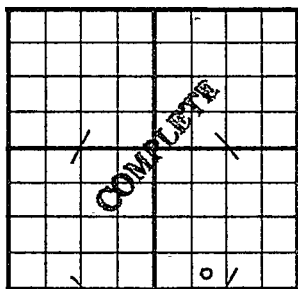County Ellsworth State KansasSec. 26 (Blk. Twp.) 17 (Sur. Rge.) 8W Map No.Operator E. K. CareyWell No. 1 Farm MaesElev. 1756 Location SE SW SE330 Ft. From S Line SE990 Ft. From W Line Quarter

1st. Report

Completion FEB 20 1952Remarks WildcatCarey Drlg. - Contr.Spudding Date 1-5-52Drlg. Data Oil well TD 33578" @ 305 DST 2832-50 open 1 hr.Rec. 225' gas 30' ocm KC 2819B KC 3147 Viola 3237 Simp. 3281Arb. 3341 DST 3341-46 open 1 hr.Rec. 30' mud DST 3346-57 open 1/2 hr.Rec. 1040' oil 100' sw TD 33575" @ 3354 CO to 3357 S/ 14 boph15% water Comp. 478 bopd 8% water

J. G. McGEHEE