

KANSAS


McPherson

FORM 51 5M 1-42 PETROL

Section 26 Township 17 Range 2-W

Well No. #1 Johnson Estate

Company Nadel & Gussman

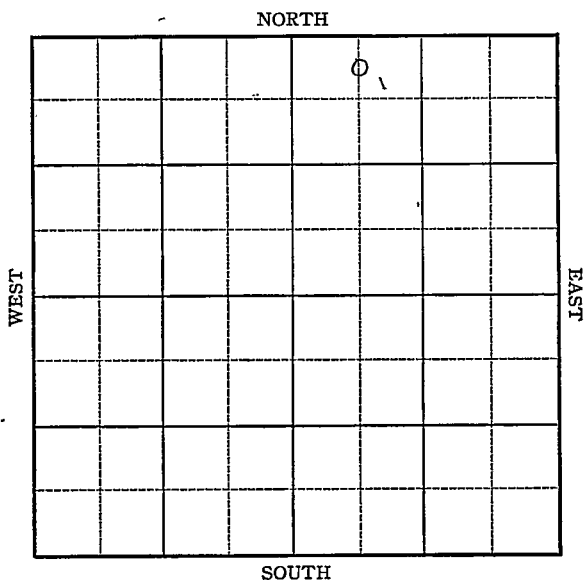

KANSAS

McPherson

Sec. 26 Twp. 17 R. 2-W

Well No. #1 Johnson Estate Farm

Nadel & Gussman Company

Lindsborg


330 Ft. from N. Line

 Ft. from S. Line

 Ft. from E. Line

660 Ft. from W. Line

Elev. 1419

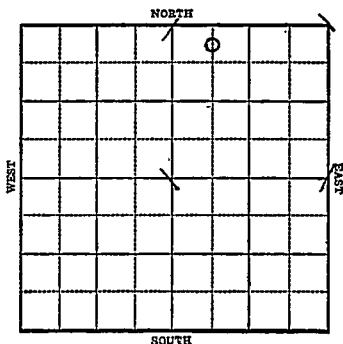

1943

R E P O R T


3/24	Location	Derby Parnout
3/31	"	"
4/7	"	
4/14	Rotary	
4/21	8" @ 140	
	Drlg. 2400'	
4/28	Lans 2220	
	Miss. 2828	
	T.D. 2845'	
	No shows.	

ABANDONED

KANSASMap No. 42 Sec. 26 Twp. 17 R. 2WWell No. 1 Johnson EstateNadel & Gussman Company**FIRST REPORT** Contractor

C NL NW NE

SECTION PLAT

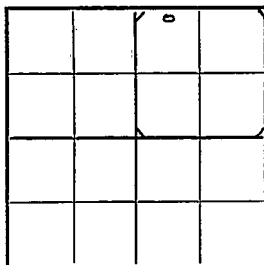330 Ft. from N. Line Ft. from S. Line Ft. from E. Line660 Ft. from W. Line**LINDSBORG POOL**Location XXXRig up

Drilling and Remarks:

Derby Farmout

RECORD

Cased in., ft.Sand Gas Oil Total Depth

PRODUCTION

1st 24 hrs. Nat. 1st 24 hrs. after shot Gas Cu. Ft.Dry Hole Abandoned

Date

MAR 24 1943 19S. J. LEWIS Scout

KANSAS

McPherson

Map No. 22 Sec. 26 Twp. 17 R. 2WWell No. 1 Johnson Estate

Nadel & Gussman Company

ABANDONED Contractor


C NL NW NE

SECTION FLAT

330 Ft. from N. Line

Ft. from S. Line

Ft. from E. Line

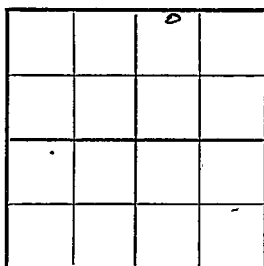660 Ft. from W. Line

LINDSBORG POOL

Location

Rig up

Drilling and Remarks:

*Loss 2220**Miss 2828**No show*

RECORD

Cased _____ in., _____ ft.

Sand _____

Gas _____

Oil _____

Total Depth 2845

PRODUCTION

1st 24 hrs. Nat. _____

1st 24 hrs. after shot _____

Gas _____ Cu. Ft.

Dry Hole _____

Abandoned _____

Date

APR 28 1943 19 S. J. LEWIS Scout