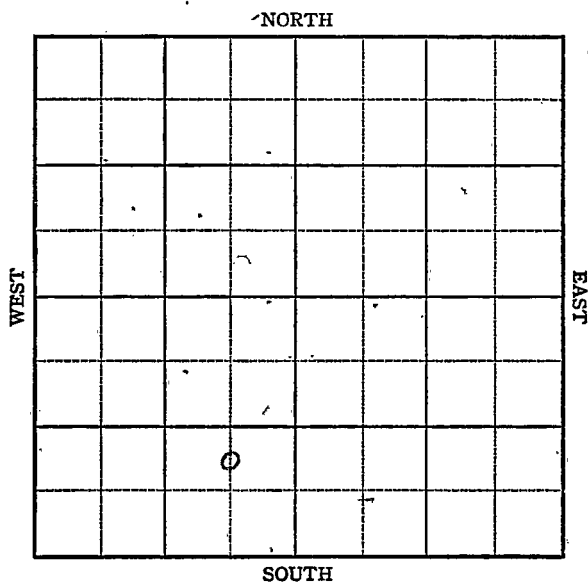


KANSAS

McPherson county

Section 26 Township 17 Range 1-WWell No. #3, SandbergCompany Westgate-Greenland

KANSAS

McPherson County

Sec. 26 Twp. 17 R. 1W

Well No. 3 Sandberg Farm

Westgate-Greenland Company


Crowther Pool

Ft. from N. Line

990 Ft. from S. Line

660 Ft. from E. Line

Ft. from W. Line

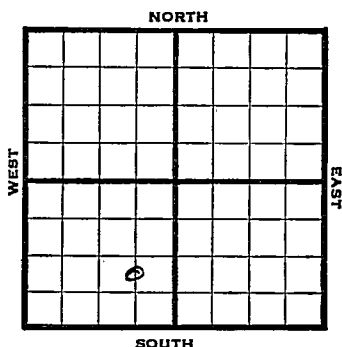

C N L SE SW

1947

Elev. 1465

REPORT

- 1/2 Location
- 1/8 Surface Hole
- 1/15 8" @ 150
Drlg 1925'
- 1/21 Miss 2784-88
TD 2788'
5" @ 2784
RUST
- 2/5 Miss 2784'
5" @ 2784
1000 acid
Pump 495 Pot
Grav. 38
TD 2793'

COMPLETED

Map No. 42 Sec. 26 Twp. 17 R. 1W

Well No. 3 Sandberg

Westgate-Greenland Company

FIRST REPORT

Contractor

C N L SE SW

SECTION PLAT

	o		

 Ft. from N. Line

990 Ft. from S. Line

660 Ft. from E. Line

 Ft. from W. Line

McPherson County

Location X

Rig up

Drilling and Remarks:

RECORD

Cased in., ft.

Sand

Gas

Oil

Total Depth

PRODUCTION

1st 24 hrs. Nat.

1st 24 hrs. after shot

Gas Cu. Ft.

Dry Hole

Abandoned

Date

JAN 2 1947 19

S. J. LEWIS Scout

Map No. 42 Sec. 26 Twp. 17 R. 1W

Well No. 3 Sandberg

Westgate-Greenland Company

COMPLETE

Contractor

C N L SE SW

E1, 1465

SECTION PLAT

	6		

 Ft. from N. Line

990 Ft. from S. Line

660 Ft. from E. Line

 Ft. from W. Line

McPherson County

Location

Rig up

Drilling and Remarks:

*Miss 2784
5" @ 2784
1000 acid
Pump 495 P.D.*

38° Gr

RECORD

Cased in., ft.

Sand

Gas

Oil

Total Depth 2783

PRODUCTION

1st 24 hrs. Nat.

1st 24 hrs. after shot

Gas Cu. Ft.

Dry Hole

Abandoned

Date

FEB 5 1947 19 S. J. LEWIS Scout