


Section 26 Township 17 Range 1W

Well No. 4 Crowther

Company Westgate-Greenland

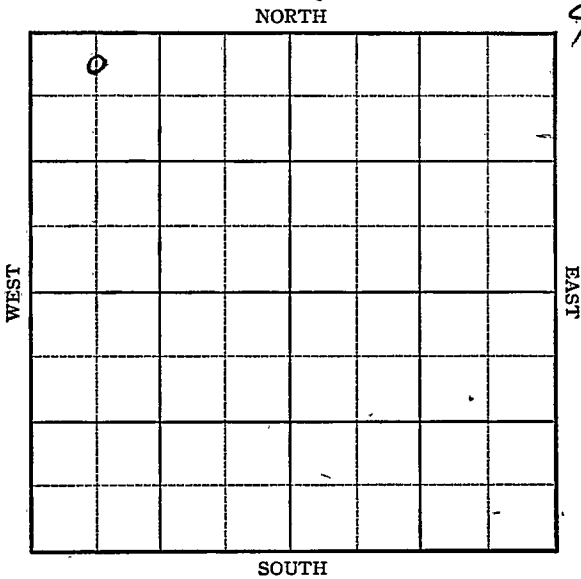

KANSAS

Sec. 26 Twp. 17 R. 1W

Well No. #4 Crowther Farm _____

Westgate-Greenland Company _____


Crowther

330 Ft. from N. Line

_____ Ft. from S. Line

_____ Ft. from E. Line

660 Ft. from W. Line

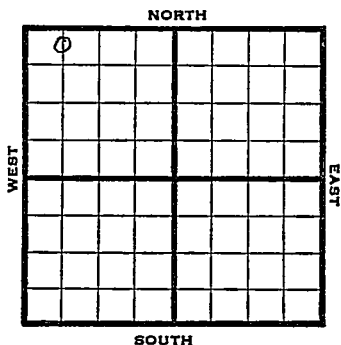

CNL NW NW

1946 Elev 1437' REPORT

5/8 Location

4/5 Miss 2759-61 TD
5" @ 2659 R^UST

5/21 TD 2780 $\frac{1}{2}$
1375' W 180' oil
PB 2778
1000 acid

5/29 Miss 2759
5" @ 2759
PB 2778
TD 2780 $\frac{1}{2}$
1000 acid
Pump 380 oil plus 35 W Pot
39.0 Gr.

COMPLETED

KANSAS

Kansas Pool Name Crowther

Map No. 42 Sec. 26 Twp. 17 R. 1W

Well No. 4 Crowther

Westgate-Greenland Company

FIRST REPORT Contractor

C N L NW NW

SECTION PLAT

330 Ft. from N. Line

_____ Ft. from S. Line

_____ Ft. from E. Line

660 Ft. from W. Line

0			

McPherson County

RECORD

Location _____

Cased _____ in., _____ ft.

Rig up _____

Sand _____

Drilling and Remarks:

Gas _____

Oil _____

Total Depth _____

PRODUCTION

1st 24 hrs. Nat. _____

1st 24 hrs. after shot _____

Gas _____ Cu. Ft.

Dry Hole _____

Abandoned _____

Date _____

MAY 8 1946 19

S. J. LEWIS Scout

KANSAS Pool Name Crowther Pool

Map No. 2 Sec. 26 Twp. 17 R. 1W

Well No. 4 Crowther

Westgate-Greenland Company

COMPLETED

Contractor

C N L NW NW

E11437

SECTION PLAT

330 Ft. from N. Line

_____ Ft. from S. Line

_____ Ft. from E. Line

660 Ft. from W. Line

0			

McPherson County

Location _____

Rig up _____

Drilling and Remarks:

Miss 275.9
5" @ 2709
PS 2778
1000 acid
Run 380' oil + 35'
BT
39-1/2

RECORD

Cased _____ in., _____ ft.

Sand _____

Gas _____

Oil _____

Total Depth 2780 1/2

PRODUCTION

1st 24 hrs. Nat. _____

1st 24 hrs. after shot _____

Gas _____ Cu. Ft.

Dry Hole _____

Abandoned _____

Date

MAY 29 1946

S. J. LEWIS Scout