

KANSAS

FORM 51 5M 10-41 PETROL


McPherson

Section 26 Township 17 Range 1-W

Well No. #1 Crowther

Company Westgate-Greenland

Roxbury Pool

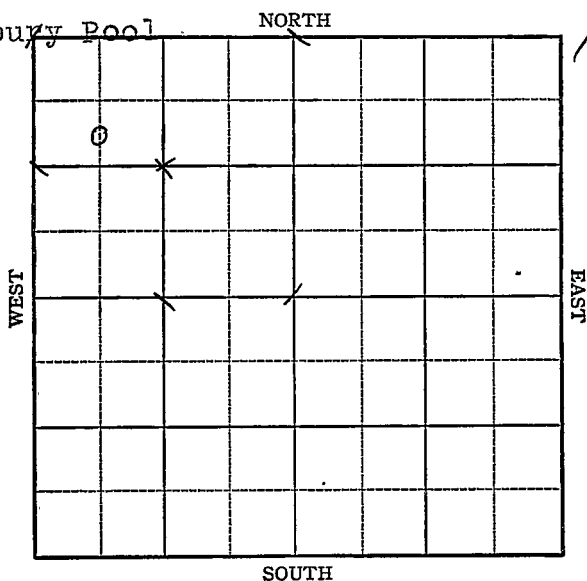


Sec. 26 Twp. 17 R. 1-WWell No. #1 Crowther FarmWestgate-Greenland Company

(Roxbury Pool)

990 Ft. from N. Line Ft. from S. Line Ft. from E. Line660 Ft. from W. Line

Elev. 1466

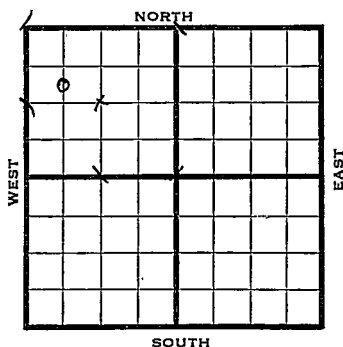

1942

REPORT

8/12	Location	
8/19	10" - 151	Drlg. 753'
8/27	Drlg 2355	
9/2	Lans. 2190	Miss. 2782
	Viola 3280	Simp. 3380
	T.D. 3422	7" - 2852
	RUST.	
9/9	28 shots 2793-2802	
	23 " 2779-88 700' oil	
	1500' water 'in 16 hrs.	
9/16	Squeeze off perforation.	
9/23	35 shots 2778-94 Esti 125 oil a day.	
9/30	Lansing 2190	
	Miss. 2782	
	Viola 3280	
	Simp. 3380	
	7" 2852	
	TD 3422	
	Perf 2778-94 - 35	
	Phy. Pot. 151 bopd 3% wtr.	
	35 grav.	

COMPLETED

Map No. 42 Sec. 26 Twp. 17 R. 1WWell No. 1 CrowtherWestgate-Greenland

Company

FIRST REPORT

Contractor


SECTION PLAT

C S L NW NW

990 Ft. from N. Line

_____ Ft. from S. Line

_____ Ft. from E. Line

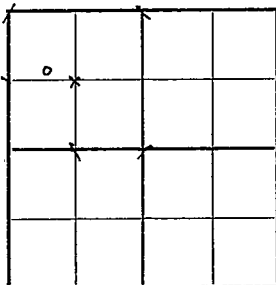660 Ft. from W. Line

ROXBURY POOL

X

Location _____

Rig up _____

Drilling and Remarks:

RECORD

Cased _____ in., _____ ft.

Sand _____

Gas _____

Oil _____

Total Depth _____

PRODUCTION

1st 24 hrs. Nat. _____

1st 24 hrs. after shot _____

Gas _____ Cu. Ft.

Dry Hole _____

Abandoned _____

Date

AUG 12 1942 19

S. J. LEWIS

Scott

Misc Small Maps	<i>DM</i>
Cards	<i>One</i>
Tracing	<i>1/2</i>
France Map	<i>DM</i>
Scarborough Map	
Moody Map	<i>1/2</i>
Geological Dept.	
Moody Plat Book	

Lansing 2190

Miss 2782-

Viola 3280

Simp 3380

Misc. Small Maps	✓
Cards	✓
Tracing	✓
France Map	✓
Scarborough Map	✓
Moody Map	✓
Geological Dept.	
Moody Flat Book	