


Section 27 Township 17 Range 9-W

Well Number #2-Anna

Company Carter et al

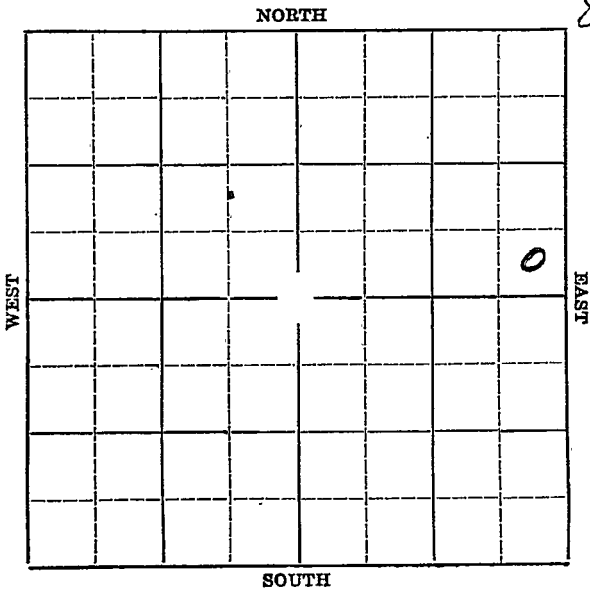

O. W. D. D

KANSAS Ellsworth

Sec. 27 Twp. 17 R. 97

Well No. #2 Anna Farm


Carter et al Company

_____ Ft. from N. Line

330' Ft. from S. Line

330' Ft. from E. Line

_____ Ft. from W. Line

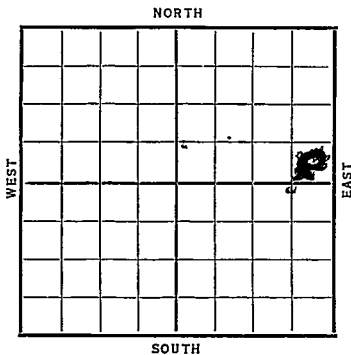

Elev. 1768

Date	REPORT
1938	O. W. D. D
8/19	Rig on ground.
8/27	10" @ 218'. WOC.
9/3	Drlg. 2035'.
9/10	Drlg. 2985'.
9/18	Siliceous 3162-Set 7". rust.
9/24	T.D. 3195'. Shot 40 qts. 3183-93'
	Clean out.
10/1	Will drill deeper.
10/8	--
10/15	T.D. 3196'. Pump 137 bbls of
	oil in 19 hours.
10/22	Will make water disposal well.
10/28	Shut down.
11/4	Sil. 3162
	T. D. 3196
	35 oil 305 water
	D & A
	ABANDONED
	OVER

O. W. D. D

1937

3/31 T.D. 3628'.

Water disposal.

Take 128 bbls. water per hour
by Gravity.

FIRST REPORT

W and

ABANDONED

[Handwritten scribbles and lines]

Returned.....	<i>[Signature]</i>
Cards.....	<i>[Signature]</i>
Tracing.....	<i>[Signature]</i>
France Map.....	<i>[Signature]</i>
Scarborough Map.....	<i>[Signature]</i>
Moody Map.....	<i>[Signature]</i>
Scarborough Plat Book.....	
Moody Plat Book.....	

Map No. 45 Sec. 27 Twp. 17 R. 9W

Well No. 2 Anna

Orsted & Co Company

Contractor

SECTION PLAT

			0

_____ Ft. from N. Line

880 Ft. from S. Line

320 Ft. from E. Line

_____ Ft. from W. Line

ABANDONED

Location _____

Rig up _____

Drilling and Remarks: ,

Sil 3162.
35 oil 305 Water

J.A.

RECORD

Cased _____ in., _____ ft.

Sand _____

Gas _____

Oil _____

Total Depth 3196

PRODUCTION

1st 24 hrs. Nat. _____

1st 24 hrs. after shot _____

Gas _____ Cu. Ft.

Dry Hole _____

Abandoned _____

Date

NOV 4 1936 19

J. J. LEWIS Scout

Handwritten scribbles and lines, possibly representing a signature or a map outline.

Returned
Cards	<i>Paul</i>
Tracing	<i>Joe</i>
France Map	<i>[Signature]</i>
Scarborough Map	<i>[Signature]</i>
Moody Map
Scarborough Plat Book
Moody Plat Book

Map No. 45 Sec. 27 Twp. 17 R. 9W

Well No. 2 Anna

Carter Company

Contractor

SECTION PLAT

			0

_____ Ft. from N. Line

330 Ft. from S. Line

330 Ft. from E. Line

_____ Ft. from W. Line

**FIRST REPORT
COMPLETED**

DWDD

Location _____

Rig up _____

Drilling and Remarks:

*take 1288 lb
water per hr by
gravity
Water Disposal*

RECORD

Cased _____ in., _____ ft.

Sand _____

Gas _____

Oil _____

Total Depth 3628

PRODUCTION

1st 24 hrs. Nat. _____

1st 24 hrs. after shot _____

Gas _____ Cu. Ft.

Dry Hole _____

Abandoned _____

Date

MAR 31 1937

19

S. J. LEWIS

Scout

[Handwritten signature]

RAY

Returned
Cards <i>Paul</i>
Tracing <i>Joe</i>
Fran's Map <i>[Signature]</i>
Scarborough Map <i>[Signature]</i>
Moody Map
Scarborough Plat Book
Moody Plat Book