


Section 27 Township 17 Range 9-W

Well Number #1 Georgia

Company Carter Oil et al

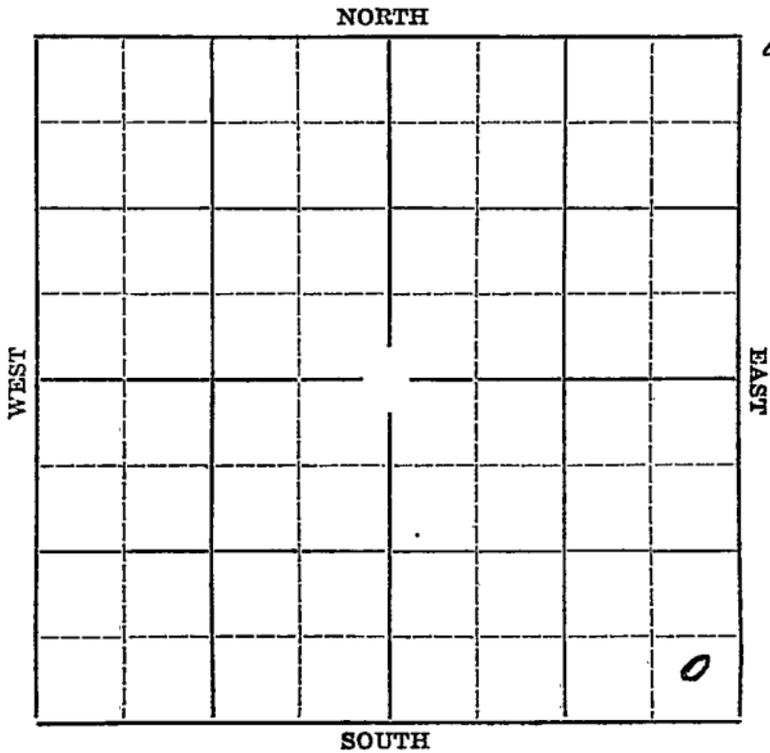



Map No. 45 Sec. 27 Twp. 17 R. 9W

Well No. 1 Georgia

Carter Oil & Co. Company

Contractor

SECTION PLAT

|  |  |  |   |
|--|--|--|---|
|  |  |  |   |
|  |  |  |   |
|  |  |  |   |
|  |  |  |   |
|  |  |  | 0 |

\_\_\_\_\_ Ft. from N. Line

330 Ft. from S. Line

230 Ft. from E. Line

\_\_\_\_\_ Ft. from W. Line

FIRST REPORT

Location \_\_\_\_\_

Rig up \_\_\_\_\_

Drilling and Remarks:

*Rig*

RECORD

Cased \_\_\_\_\_ in., \_\_\_\_\_ ft.

Sand \_\_\_\_\_

Gas \_\_\_\_\_

Oil \_\_\_\_\_

Total Depth \_\_\_\_\_

PRODUCTION

1st 24 hrs. Nat. \_\_\_\_\_

1st 24 hrs. after shot \_\_\_\_\_

Gas \_\_\_\_\_ Cu. Ft.

Dry Hole \_\_\_\_\_

Abandoned \_\_\_\_\_

Date

OCT 14 1936 19

S. J. LEWIS Scout

Map No. 45 Sec. 27 Twp. 17 R. 9W

Well No. 1 Georgia

Carter Oil Company

Contractor

**SECTION PLAT**

|  |  |  |  |
|--|--|--|--|
|  |  |  |  |
|  |  |  |  |
|  |  |  |  |
|  |  |  |  |

\_\_\_\_\_ Ft. from N. Line

330 Ft. from S. Line

330 Ft. from E. Line

\_\_\_\_\_ Ft. from W. Line

**COMPLETED**

Location \_\_\_\_\_

Rig up \_\_\_\_\_

Drilling and Remarks:

Oil 3170

Ps 81297 Nat.

**RECORD**

Cased \_\_\_\_\_ in., \_\_\_\_\_ ft.

Sand \_\_\_\_\_

Gas \_\_\_\_\_

Oil \_\_\_\_\_

Total Depth 3191

**PRODUCTION**

1st 24 hrs. Nat. \_\_\_\_\_

1st 24 hrs. after shot \_\_\_\_\_

Gas \_\_\_\_\_ Cu. Ft.

Dry Hole \_\_\_\_\_

Abandoned \_\_\_\_\_

Date

NOV 18 1936<sub>19</sub>

S. J. LEWIS Scout