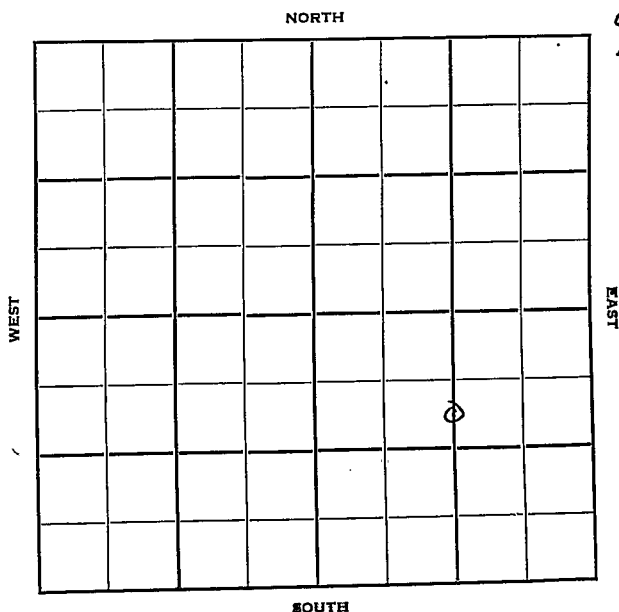


KANSAS

Ellsworth

Section 27 Township 17S Range 9WWell No. #1 GrothCompany Herndon Drlg Co.

Sec. 27 Twp. 17 R. 9-W ✓

Well No. #1 Groth Farm _____
Herndon Drlg _____ Company _____

Cont — Herndon Drlg
Lorraine


990 Ft. from N. Line

_____ Ft. from S. Line

1320 Ft. from E. Line

_____ Ft. from W. Line

G S L N $\frac{1}{2}$ SE

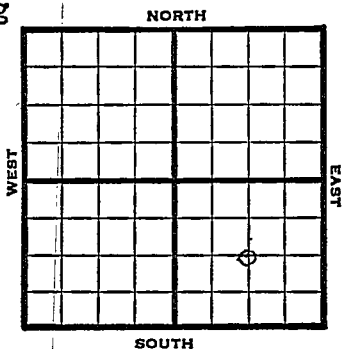

1949 Elev. 1750 $\frac{1}{2}$ REPORT

10/5	8" @ 245 Anhy 880 Drlg 2220'
10/12	Arb. 3143' TD 3147' 5" @ 3143'
10/19	Swb 8 bbls oil PH
10/26	"
11/1	"
11/9	"
11/16	TD 3147' Arb. 3143' 5 @ 3143' Pump 60 Oil $\neq$ 22% W Pot 44° Gr. Comp COMPLETED

Map No. _____ Sec. 27 Twp. 17 R. 9W

Well No. 1 Groth

Herndon Drlg.

Company

Herndon Drlg.

Contractor

C S L N $\frac{1}{2}$ SE


FIRST REPORT
SECTION PLAT

990 Ft. from N. Line

Ft. from S. Line

1320 Ft. from E. Line

Ft. from W. Line

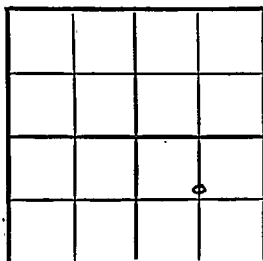

Ellsworth County

Location

Rig up

Drilling and Remarks:

8" @ 245

Anhy 880

drlg. 2220

RECORD

Cased _____ in., _____ ft.

Sand _____

Gas _____

Oil _____

Total Depth _____

PRODUCTION

1st 24 hrs. Nat. _____

1st 24 hrs. after shot _____

Gas _____ Cu. Ft.

Dry Hole _____

Abandoned _____

Date

OCT 5 1949 19

S. J. LEWIS

Scout

Kansas

Lorraine Pool

Map No. _____ Sec. 27 Twp. 17 R. 9W

Well No. 1 Groth

Herndon Drlg. Company

COMPLETE

Contractor


C S L N $\frac{1}{2}$ SEE. 1. 1788
SECTION PLAT

990 Ft. from N. Line

_____ Ft. from S. Line

1320 Ft. from E. Line

_____ Ft. from W. Line

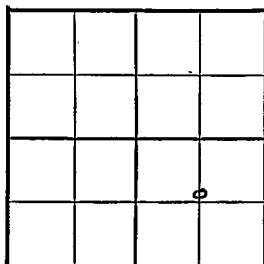

Ellsworth County

Location _____

Rig up _____

Drilling and Remarks:

*Cr 8 3/4"**5" @ 3143**Pump 60 rods + 22 9/16"**OK**44° S*

RECORD

Cased _____ in., _____ ft.

Sand _____

Gas _____

Oil _____

Total Depth *3147*

PRODUCTION

1st 24 hrs. Nat. _____

1st 24 hrs. after shot _____

Gas _____ Cu. Ft.

Dry Hole _____

Abandoned _____

Date

NOV 16 1949

19

S. J. LEWIS

Scout