


KANSAS

Section 27 Township 17 Range 9W

Well No. #5 Groth

Company Herndon Drlg.

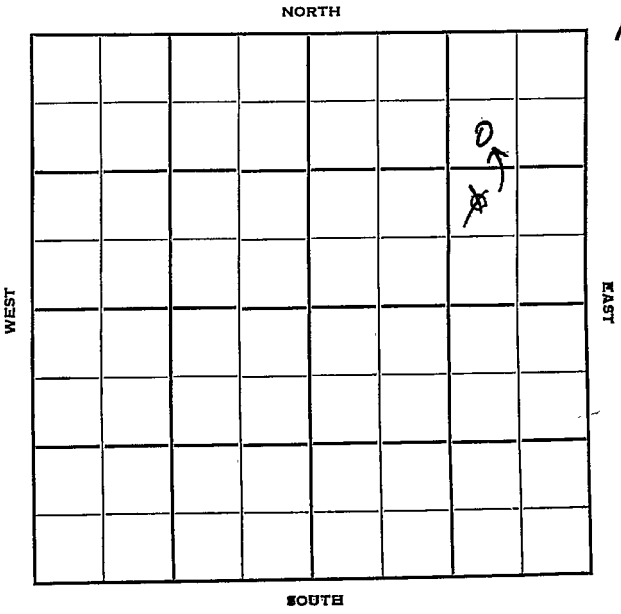

Sec. 27 Twp. 17 R. 9-W

Well No. #5 Groth Farm

Herndon Drlg. Company

Henderson Drlg. Contr. Contractor

Lorraine


990 Ft. from N. Line

-990 Ft. from S. Line

990 Ft. from E. Line

\_\_\_\_\_ Ft. from W. Line

~~NW SE NE~~  
~~SW NE NE~~

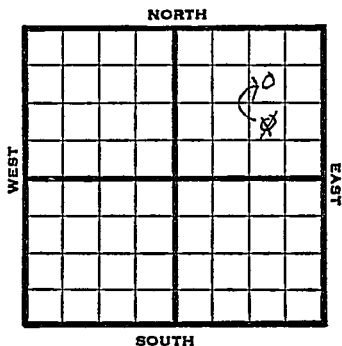

1950 Elev. 1775' REPORT

9/27 Spud 9-25-50  
8 5/8" @ 236

10/18 Spud 9-25-50  
D&A TD 3206  
9-5/8" @ 236'  
Lans. 2854' Arb. 3182-84  
5" @ 3183 TD 3206  
1 BFPH 75% wtr 500 A 8 BW  
3 GOPH D&A  
**ABANDONED**



Map No. \_\_\_\_\_ Sec. 27 Twp. 17 R. 9WWell No. 5 Groth

Herndon Drlg. \_\_\_\_\_ Company

CORRECTION

\_\_\_\_\_ Contractor

SW NE NE

## SECTION PLAT

990 Ft. from N. Line

\_\_\_\_\_ Ft. from S. Line

990 Ft. from E. Line

\_\_\_\_\_ Ft. from W. Line

			0

Ellsworth County

Location \_\_\_\_\_

Rig up \_\_\_\_\_

Drilling and Remarks:

Reported

NW SE NE

## RECORD

Cased \_\_\_\_\_ in., \_\_\_\_\_ ft.

Sand \_\_\_\_\_

Gas \_\_\_\_\_

Oil \_\_\_\_\_

Total Depth \_\_\_\_\_

## PRODUCTION

1st 24 hrs. Nat. \_\_\_\_\_

1st 24 hrs. after shot \_\_\_\_\_

Gas \_\_\_\_\_ Cu. Ft.

Dry Hole \_\_\_\_\_

Abandoned \_\_\_\_\_

Date

OCT 4 1950 19J. E. TYRA Scout

