FORM 51 25M 3-49 PETROL


KANSAS

Ellsworth

Section 27 Township 17 Range 9-W

Well No. #3A. Groth

Company Hearndon Drlg.

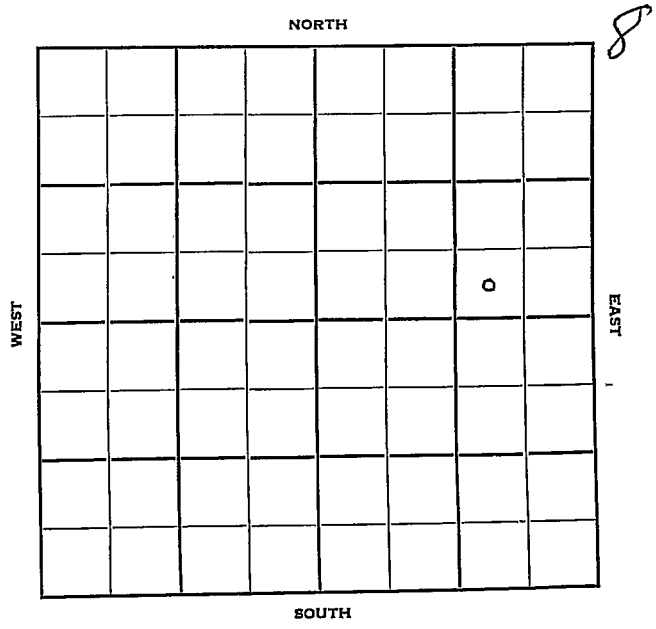

FORM 252-B
10M 9-49 PETROL

Ellsworth KANSAS

Sec. 27 Twp. 17 R. 9W

Well No. #3 A. Groth Farm

Hearndon Drlg. Company

Contractor


Ft. from N. Line

330' Ft. from S. Line

990' Ft. from E. Line

Ft. from W. Line

SW SE NE

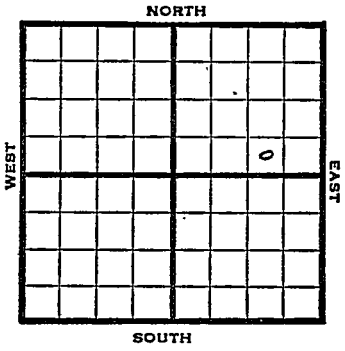

1950	REPORT
	Elev 1779
5/17	Spud 5-15-50 8-5/8" @ 135' WOC
6/21	8 5/8" @ 135 Lans 2861 Arb 3166 TD 3178 5" @ 3175 500 acid Comp 40 bopd + 5% wtr Completed
	COMPLETED

Form 26 200 Bks. 11-49 Petrol

Kansas

Map No. _____ Sec. 27 Twp. 17 R. 9W


Well No. 3A. Groth

Hearndon Drlg. Company

Contractor

SW SE NE.

SECTION PLAT

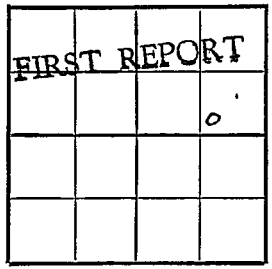

_____ Ft. from N. Line

330 Ft. from S. Line

990 Ft. from E. Line

_____ Ft. from W. Line

Ellsworth

Location _____

Rig up _____

Drilling and Remarks:

Spud. 5-15-50

8 5/8" @ 135

W. O. C.

RECORD

Cased _____ in., _____ ft.

Sand _____

Gas _____

Oil _____

Total Depth _____

PRODUCTION

1st 24 hrs. Nat. _____

1st 24 hrs. after shot _____

Gas _____ Cu. Ft.

Dry Hole _____

Abandoned _____

Date

MAY 17 1950

19

J. E. TYRA Scout

Form 26 200 Bks. 11-49 Petrol

Kansas

Map No. ____ Sec. 27 Twp. 17 R. 9W

Well No. 3 A. Groth


Herndon Drlg. Company

Contractor

SW SE NE

El. 1779

SECTION PLAT

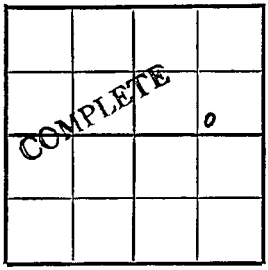

____ Ft. from N. Line

330 Ft. from S. Line

990 Ft. from E. Line

____ Ft. from W. Line

Ellsworth County

Location

Rig up

Drilling and Remarks:

8 5/8" @ 135

Lans. 2861

Arb. 3166

TD 3178

5" @ 3175

500 acid

RECORD

Cased ____ in., ____ ft.

Sand

Gas

Oil

Total Depth 3178

PRODUCTION

1st 24 hrs. Nat.

1st 24 hrs. after shot

Gas ____ Cu. Ft.

Dry Hole

Abandoned

Comp. 40 bopd + 5% water

Date

JUN 21 1950 19

J. E. TYRA Scout