
FORM 51 25M 3-49 PETROL KANSAS Ellsworth

Section 27 Township 17S Range 9W

Well No. #2-Groth

Company Herndon Drlg. Co.

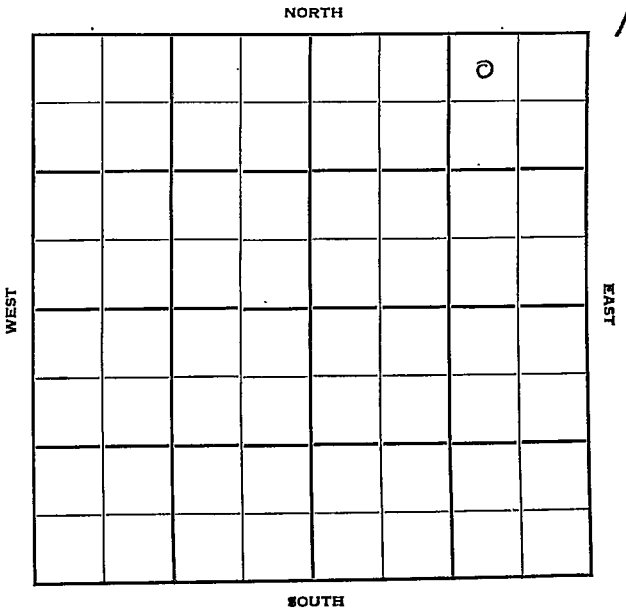

FORM 252-A
5M 10-48 PETROL

KANSAS

Ellsworth

Sec. 27 Twp. 17 R. 9-W

Well No. #2 Groth Farm

Herndon Drlg Company

Cont— Herndon Drlg
Lorraine


330 Ft. from N. Line

Ft. from S. Line

990 Ft. from E. Line

Ft. from W. Line

NW NE NE

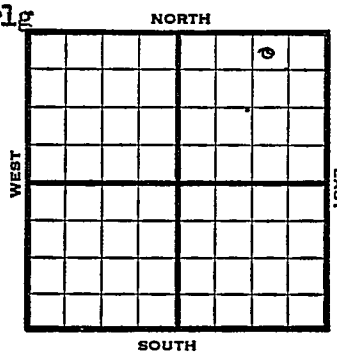

1949	Elev. 1759' REPORT
10/12	8"@ 242'
10/19	Drlg 3042'
10/26	Lansing 2838' Arb 3164' TD 3182' 5" @ 3164'
11/1	500 acid Swb 35 bbls oil PH
11/9	"
11/16	TD 3185' Arb. 3164' 5"@ 3164' 500 acid Pump 50 Oil Pot 44° Gr. Comp
	COMPLETED

Form 26 200 Bks. 6-49 Petrol
Kansas

Lorraine Pool

Map No. ____ Sec. 27 Twp. 17 R. 9W

Well No. 2 Groth


Herndon Drlg. Company

Herndon Drlg. Contractor

NW NE NE

FIRST REPORT

SECTION PLAT

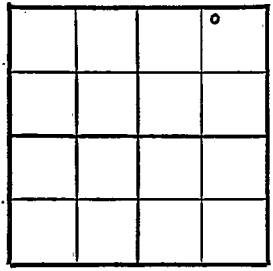

330 Ft. from N. Line

Ft. from S. Line

990 Ft. from E. Line

Ft. from W. Line

Ellsworth County

Location

Rig up

Drilling and Remarks:

8" @ 242

RECORD

Cased ____ in., ____ ft.

Sand

Gas

Oil

Total Depth

PRODUCTION

1st 24 hrs. Nat.

1st 24 hrs. after shot

Gas ____ Cu. Ft.

Dry Hole

Abandoned

Date

OCT 12 1949 19

S. J. LEWIS Scout

Form 26 200 Bks. 6-49 Petrol

Kansas

Lorraine Pool

Map No. ____ Sec. 27 Twp. 17 R. 9W

Well No. 2 Groth

Herndon Drlg. Company


COMPLETE

Contractor

NW NE NE

E. 1959

SECTION PLAT

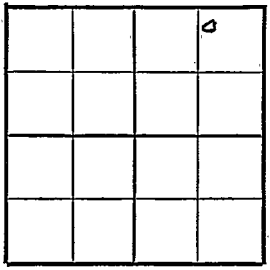

330 Ft. from N. Line

____ Ft. from S. Line

990 Ft. from E. Line

____ Ft. from W. Line

Ellsworth County

Location ____

Rig up ____

Drilling and Remarks:

Cer + 3/164

5" @ 3164

500 acid

Pump & bail BF

440 Gr.

RECORD

Cased ____ in., ____ ft.

Sand ____

Gas ____

Oil ____

Total Depth 3185'

PRODUCTION

1st 24 hrs. Nat. ____

1st 24 hrs. after shot ____

Gas ____ Cu. Ft.

Dry Hole ____

Abandoned ____

Date

NOV 16 1949 19

S. J. LEWIS Scout