

# KANSAS


Form 51-5M-7-40-Palace

Ellsworth

Section 27 Township 17 Range 8-W

Well No. #5 Ploog "A"

Company Continental et al

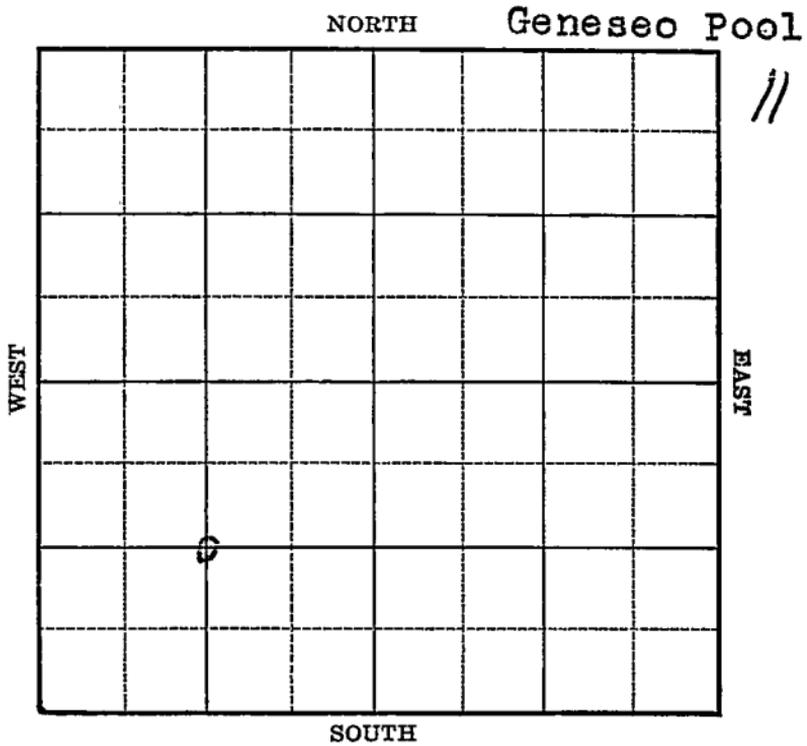

Sec. 27 Twp. 17 R. 8-W

Well No. #5 Ploog "A" Farm

Continental et al Company


(Geneseo)

           Ft. from N. Line

1320 Ft. from S. Line

           Ft. from E. Line

146 Ft. from W. Line

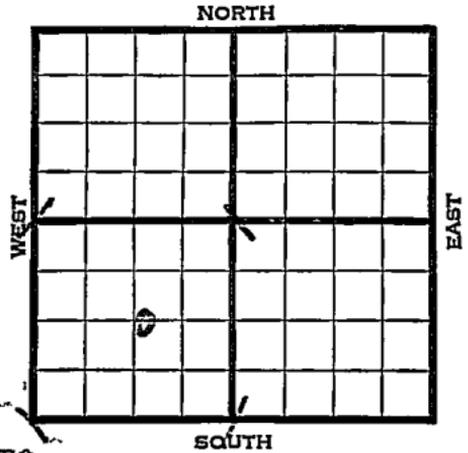

Elev. 1778

REPORT

1941  
3/5

10" - 200'  
Drlg. 1200'

3/13

Arb. 3239 -43' T.D. 6" - 3240'  
RUST.

3/20

T.D. 3243' 3100' oil.

3/26

Arb. 3239'  
6" - 3240'  
T.D. 3243'  
1000 acid.

Echometer potential 12,399 bbls.  
Maximum 3000 bbls.  
40.1 Gravity


**COMPLETED**

Map No. 45 Sec. 27 Twp. 17 R. 8WWell No. 5 Ploog "A"Continental etal CompanyFIRST REPORT Contractor**SECTION PLAT**

C SW

         Ft. from N. Line1320 Ft. from S. Line         Ft. from E. Line1416 Ft. from W. Line

GENESEO POOL

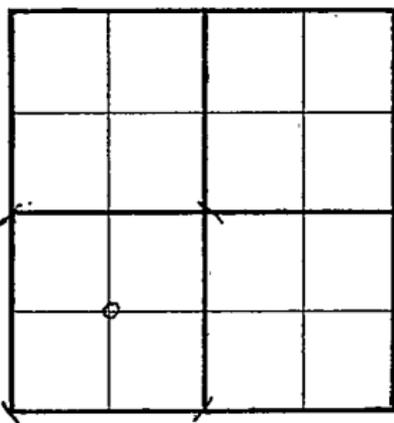Location                                 Rig up                                 

Drilling and Remarks:

10" - 200

Drlg. 1200

**RECORD**Cased          in.,          ft.Sand                                 Gas                                 Oil                                 Total Depth                         **PRODUCTION**1st 24 hrs. Nat.                         1st 24 hrs. after shot                         Gas                          Cu. Ft.Dry Hole                         Abandoned                         

Date

MAR 5 1941 19

S. J. LEWIS Scout

