

KANSAS

Ellsworth

Form 51-5M-7-40-Palace

Section 27 Township 17 Range 8-W

Well No. #6 Ploog "A"

Company Continentale t al

NORTH

Geneseo Pool

								13

WEST

EAST

SOUTH

0

Sec. 27 Twp. 17 R. 8-W

Well No. #6 Ploog "A" Farm _____

Continental et al Company


(Geneseo)

_____ Ft. from N. Line

440 Ft. from S. Line

_____ Ft. from E. Line

440 Ft. from W. Line

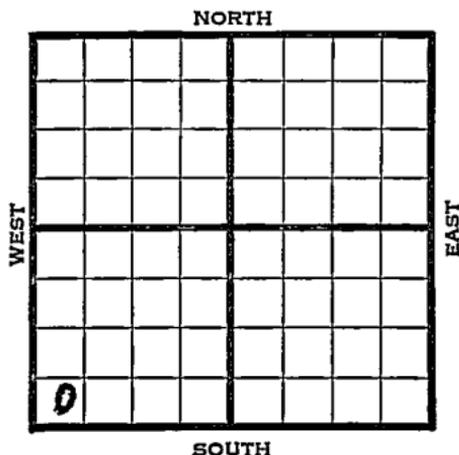

Elev. 1775

1941	REPORT
3/12	Derri ck.
3/20	10" - 203' Drlg. 605'
3/27	Drlg. 3160'
4/2	Arb. 3216' 6" - 3217'
	T.D. 3225' 3000 acid.
4/9	Arb. 3216'
	6" - 3217'
	T.D. 3225'
	3000 acid.
	Echometer potential 5229 bbls.
	Maximum 3000 bbls.
	40.1 Gravity
	COMPLETED

Map No. 45 Sec. 27 Twp. 17 R. 8W

Well No. 6 Ploog "A"

Continental etal Company

Contractor

FIRST REPORT

SW/C

_____ Ft. from N. Line

440 Ft. from S. Line

_____ Ft. from E. Line

440 Ft. from W. Line

SECTION PLAT

GENESEO POOL

Location _____

Rig up _____

Drilling and Remarks:

Derrick

RECORD

Cased _____ in., _____ ft.

Sand _____

Gas _____

Oil _____

Total Depth _____

PRODUCTION

1st 24 hrs. Nat. _____

1st 24 hrs. after shot _____

Gas _____ Cu. Ft.

Dry Hole _____

Abandoned _____

Date

MAP 12 1941 19

S I LEWIS Scout

