

KANSAS


Form 51-5M-7-40-Palace

Ellsworth

Section 27 Township 17 Range 8-W

Well No. #7 Ploog "A"

Company Continental et al

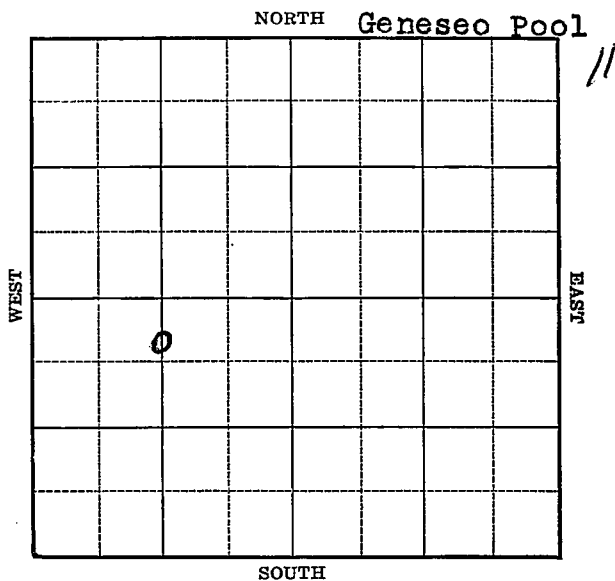


Sec. 27 Twp. 17 R. 8-WWell No. #7 Phog "A" FarmContinental et al Company

(Geneseo)

440 Ft. from N. Line Ft. from S. Line Ft. from E. Line1376 Ft. from W. Line

Elev. 1771

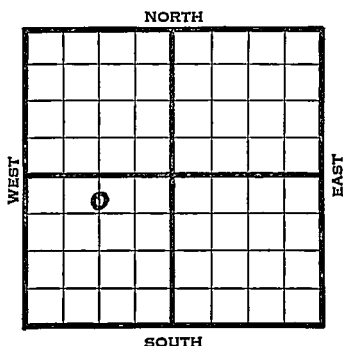

1941

REPORT

3/26 Derrick.

4/2 9" - 211' Drlg. 2575'

4/10 Arb. 3215-19' T.D. 6" - 3216'
RUST.

4/16 Arb. 3215'

T.D. 3224'

2000 acid

Echometer potential 8,155 bbls.

40.1 Gravity

COMPLETED

Map No. 45 Sec. 27 Twp. 17 R. 8WWell No. 7 Ploog "A"Continental etal CompanyFIRST REPORT Contractor

SECTION PLAT

C N L SW

440 Ft. from N. Line Ft. from S. Line Ft. from E. Line1376 Ft. from W. Line

GENESEO POOL

Location Rig up

Drilling and Remarks:

Derrick

RECORD

Cased in., ft.Sand Gas Oil Total Depth

PRODUCTION

1st 24 hrs.-Nat. 1st 24 hrs. after shot Gas Cu. Ft.Dry Hole Abandoned

Date

MAR 26 1941 19

S. J. LEWIS Scout

Map No. 45 Sec. 27 Twp. 17 R. 8WWell No. 7 Ploog "A"Continental etal Company

Contractor

COMPLETED

C N L SW

440 Ft. from N. Line Ft. from S. Line Ft. from E. Line1376 Ft. from W. Line

GENESEO POOL

SECTION PLAT

Location Rig up

Drilling and Remarks:

2000 acid
Echometer pot.8,155 H₂O40.1 Grav.**RECORD**Cased in. ft.Sand Arbuckle 3215Gas Oil Total Depth 3224**PRODUCTION**1st 24 hrs. Nat. 1st 24 hrs. after shot Gas Cu. Ft.Dry Hole Abandoned

Date

APR 16 1941 19

S. J. LEWIS

Scout