


Section 27 Township 17 Range 8-W
 Well No. 1 - W. Ploog "A"
 Company Continental et al

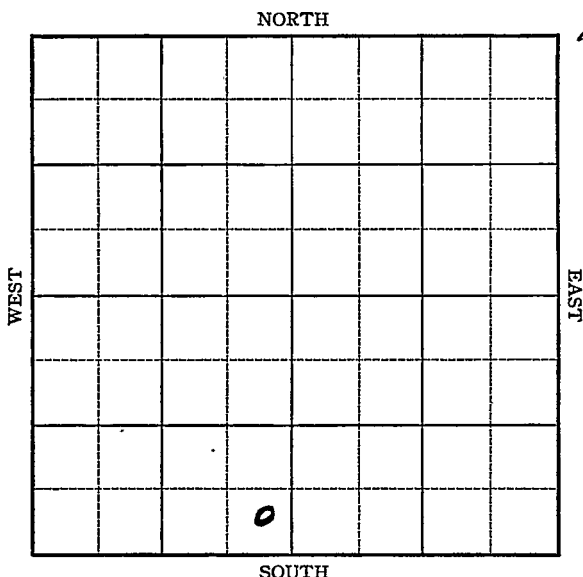

Sec. 27 Twp. 17 R. 8-W


Well No. #1 W. Ploog "A" Farm
Continental et al Company

 Ft. from N. Line

330 Ft. from S. Line

330 Ft. from E. Line

 Ft. from W. Line

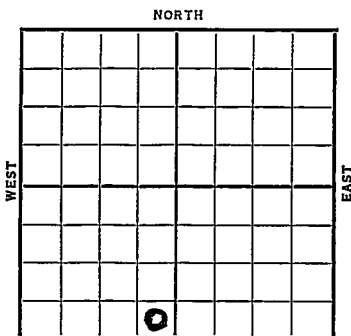

Elev. 1777

SESESW

SOUTH

Date	REPORT
1937	
6/16	B. R.
6/25	Rig
7/2	10" @ 210'. WOC.
7/9	Drilg. 2690'.
7/16	Sil. 3251'. 7" @ 3252'. WOC.
7/23	" " " " "
7/30	T.D. 3259'. Swab 117 oil
	6 hrs.
8/4	7" @ 3252'.
	Sil. 3251'.
	T.D. 3259'.
	2000 acid.
	Pump 254 $\frac{1}{2}$ bbls. 4 hrs.
	Pot. 1527 bbls.
	COMPLETED
	OVER
	C.W.W.C.

1953

O.W.W.O.

3/4	Arb. 3251 7" @ 3251 OTD 3259 DD 3342	
3/12	TD 3989'	
3/19	NR	
3/26	NR	
4/2	NR	
4/8	NR	
4/16	DD 3990, TD	
4/23	NR	
5/30	NR	
5/7	"	
5/21	"	
5/28	"	
6/1	"	
8/5	NR	
8/26	SWD well - TD 3990' 7" @ 3251 OTD 3259' DD 3989 DD 3990' Comp. for SWD well.	Arb. 3251 DD 3342

ABANDONED

KANSAS

Ellsworth

Map No. 45 Sec. 27 Twp. 17 R. 8 WWell No. 1 - W, Ploog "A"Continental Petal Company

Contractor

FIRST REPORT

SECTION PLAT

_____ Ft. from N. Line

330 Ft. from S. Line330 Ft. from E. Line

_____ Ft. from W. Line

Location _____

Rig up _____

Drilling and Remarks:

B.R.

RECORD

Cased _____ in., _____ ft.

Sand _____

Gas _____

Oil _____

Total Depth _____

PRODUCTION

1st 24 hrs. Nat. _____

1st 24 hrs. after shot _____

Gas _____ Cu. Ft.

Dry Hole _____

Abandoned _____

Date

JUN 16 1937 19

H. D. Hatfield

Scout

KANSAS

Form 26—1M Bks.—2-29

Ellsworth

Map No. 45 Sec. 27 Twp. 17 R. 8WWell No. 1-W. Ploog "A"Continental Petal Company

Contractor

COMPLETED

SECTION PLAT

_____ Ft. from N. Line

330 Ft. from S. Line330 Ft. from E. Line

_____ Ft. from W. Line

Location _____

Rig up _____

Drilling and Remarks:

2000 acidPump 254 1/2 / 4 hrsPot - 1527

RECORD

Cased 7 in., 3252 ft.Sand 511 3251

Gas _____

Oil _____

Total Depth 3259

PRODUCTION

1st 24 hrs. Nat. _____

1st 24 hrs. after shot _____

Gas _____ Cu. Ft.

Dry Hole _____

Abandoned _____

Date

AUG 4 - 1937H. D. Hatfield Scout

DD 3342

J. G. McGEHEE

