


Ellsworth

Section 27 Township 17 Range 8-W

Well No. 2 Wm. Ploog "A"

Company Continental et al

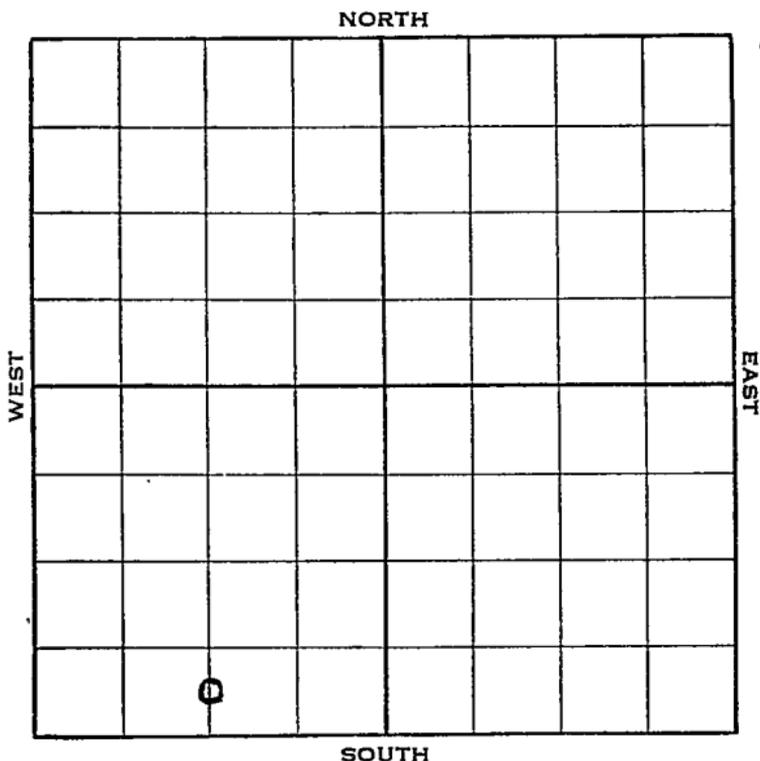

Sec. 27 Twp. 17 R. 8-W

Well No. #2 Wm. Floeg "A" Farm


Continental et al Company

\_\_\_\_\_ Ft. from N. Line

440 Ft. from S. Line

\_\_\_\_\_ Ft. from E. Line

1320 Ft. from W. Line

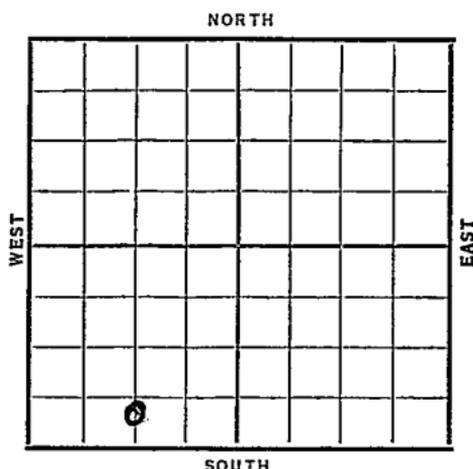

Elev. 1775'

Date	REPORT
1938	
2/2	Location
2/11	Rot. tools.
2/18	10" @ 228'. Drlg. 1245'.
2/26	Drlg. 3047'.
3/4-	Arb. 3244'. 7" @ 3245'.
	T.D. 3246'. RUST.
3/11	T.D. 3254'. 3100' oil.
3/16	7" @ 3245'.
	Arb. 3244'.
	T.D. 3254'.
	Potential 1668 bbls.
	<b>COMPLETED</b>

Map No. \_\_\_\_\_ Sec. 27 Twp. 17 R. 8WWell No. 2 Wm. Ploog "A"Continental etal Company

Contractor \_\_\_\_\_

**FIRST REPORT****C S L SW**

\_\_\_\_\_ Ft. from N. Line

440 Ft. from S. Line

\_\_\_\_\_ Ft. from E. Line

1320 Ft. from W. Line**SECTION PLAT**


Location X

Rig up \_\_\_\_\_

Drilling and Remarks:

**RECORD**

Cased \_\_\_\_\_ in., \_\_\_\_\_ ft.

Sand \_\_\_\_\_

Gas \_\_\_\_\_

Oil \_\_\_\_\_

Total Depth \_\_\_\_\_

**PRODUCTION**~~1st~~ 24-hrs. Nat. \_\_\_\_\_

1st 24 hrs. after shot \_\_\_\_\_

Gas \_\_\_\_\_ Cu. Ft.

Dry Hole \_\_\_\_\_

Abandoned \_\_\_\_\_

Date

FEB 2 1938 19 H. D. Hatfield Scout

Map No. 45 Sec. 27 Twp. 17 R. 8W

Well No. 2 Wm. Ploog "A"

Continental Etal Company

Contractor

**COMPLETED**

**SECTION PLAT**

**C S L SW**

\_\_\_\_\_ Ft. from N. Line

440 Ft. from S. Line

\_\_\_\_\_ Ft. from E. Line

1320 Ft. from W. Line


Location \_\_\_\_\_

Rig up \_\_\_\_\_

Drilling and Remarks:

*P.O.T 1668*

**RECORD**

Cased 7 in., 3245 ft.

Sand Arb 3244

Gas \_\_\_\_\_

Oil \_\_\_\_\_

Total Depth 3254

**PRODUCTION**

1st 24 hrs. Nat. \_\_\_\_\_

1st 24 hrs. after shot \_\_\_\_\_

Gas \_\_\_\_\_ Cu. Ft.

Dry Hole \_\_\_\_\_

Abandoned \_\_\_\_\_

Date

**MAR 16 1938**

19

**H. D. Hatfield** Scout