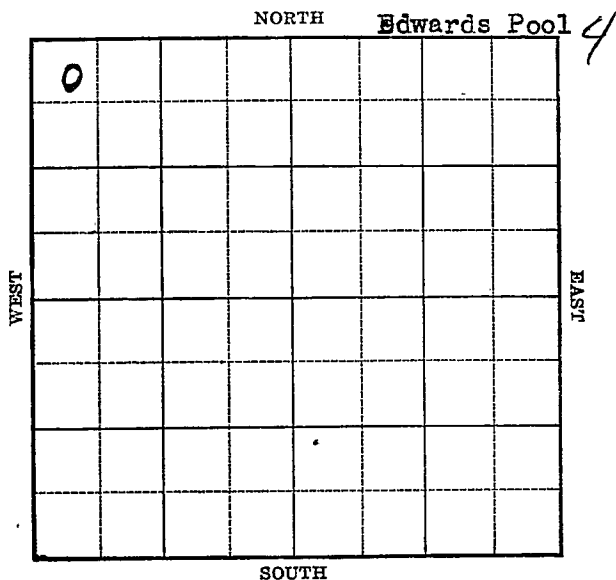


Section 27 Township 17 Range 8-WWell No. #3 SteinbergCompany Continental et al

KANSAS


Ellsworth

Sec. 27 Twp. 17 R. 8-WWell No. #3 Steinberg FarmContinental et al Company

(Edwards)

440 Ft. from N. Line Ft. from S. Line Ft. from E. Line440 Ft. from W. Line

Elev. 1789

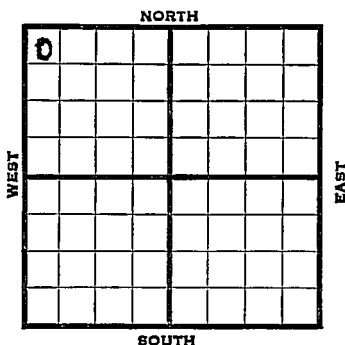

1939

REPORT

1/18

Cellar.

1/27

10" - 220'. Drlg. 709.

2/3

Drlg. 3027'.

2/10

Arb. 3195'. T.D. 3200'.

7" - 3196'. RUST.

2/17

2000' oil at 3216'

T.D. 3246 2800' oil.

3000 acid.

2/21

7" - 3196'

Arb. 3195'

T. D. 3246'

6000 acid (Total)

Pump 564 bbls. 8 hrs.

Potential 1692 bbls. No water.

COMPLETED

Map No. _____ Sec. 27 Twp. 17 R. 8WWell No. 3 SteinbergContinental etal Company

Contractor _____

FIRST REPORT

NW/C

440 Ft. from N. Line

_____ Ft. from S. Line

_____ Ft. from E. Line

440 Ft. from W. Line

EDWARDS POOL

SECTION PLAT

0			

Location _____

Rig up _____

Drilling and Remarks:

Cellar

RECORD

Cased _____ in., _____ ft.

Sand _____

Gas _____

Oil _____

Total Depth _____

PRODUCTION

1st 24 hrs. Nat. _____

1st 24 hrs. after shot _____

Gas _____ Cu. Ft.

Dry Hole _____

Abandoned _____

Date

JAN 18 1939

19

H. D. Hatfield

Scout

Ellsworth **KANSAS**Map No. 45 Sec. 27 Twp. 17 R. 8WWell No. 3 SteinbergContinental etal Company

Contractor

COMPLETED

NW/C

440 Ft. from N. Line Ft. from S. Line Ft. from E. Line440 Ft. from W. Line**EDWARDS POOL****SECTION PLAT**

0			

Location Rig up

Drilling and Remarks:

6000 Acid (Total)P-564/8Pot 1692
NO WTR**RECORD**Cased 7 in., 3196 ft.Sand Arb 3195Gas Oil Total Depth 3246**PRODUCTION**1st 24 hrs. Nat. 1st 24 hrs. after shot Gas Cu. Ft.Dry Hole Abandoned

Date

FEB 21 1939 19H. D. Hatfield

Scout