

KANSAS

Form 51-5M-7-40-Palace


Ellsworth

Section 27 Township 17 Range 8-W

Well No. #5 Steinberg

Company Continental et al

NORTH Geneseo Pool *4*

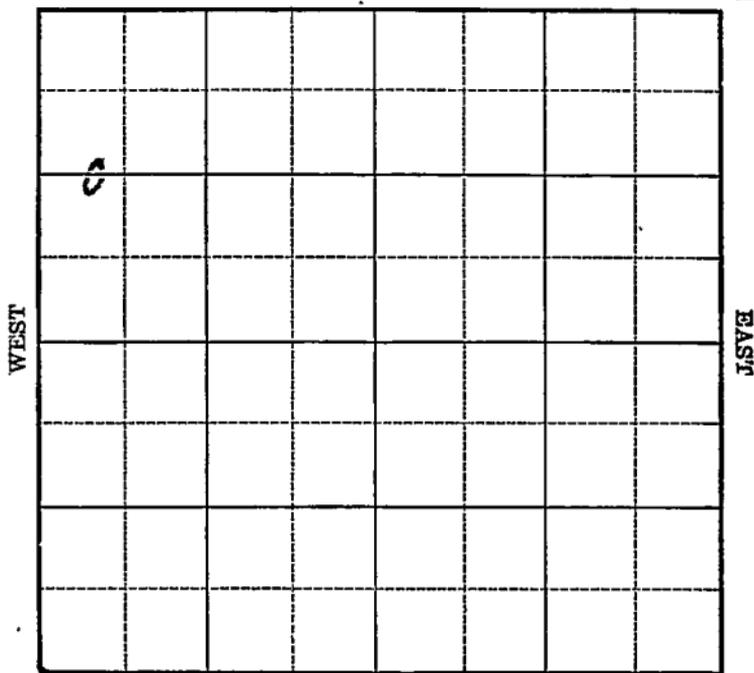

SOUTH

Map No. _____ Sec. 27 Twp. 18 R. 8W

Well No. 5 Steinberg
Continental etal Company

Contractor _____

FIRST REPORT

C W L NW

_____ Ft. from N. Line

1320 Ft. from S. Line

_____ Ft. from E. Line

440 Ft. from W. Line

SECTION PLAT

GENESEO POOL

Location _____

Rig up _____

Drilling and Remarks:
Rotary

RECORD

Cased _____ in., _____ ft.

Sand _____

Gas _____

Oil _____

Total Depth _____

PRODUCTION

1st 24 hrs. Nat. _____

1st 24 hrs. after shot _____

Gas _____ Cu. Ft.

Dry Hole _____

Abandoned _____

Date

AUG 28 1940 19

S. J. LEWIS

Scout

Map No. 45 Sec. 27 Twp. 17 R. 8W

Well No. 5 Steinberg

Continental etal Company

Contractor

COMPLETED

SECTION PLAT

C W L NW

_____ Ft. from N. Line

1320 Ft. from S. Line

_____ Ft. from E. Line

440 Ft. from W. Line

GENESEO POOL

Location _____

Rig up _____

Drilling and Remarks:

*Ar 8202.
7" @ 8203
3000 acid
Pump. 299 P.X.*

RECORD

Cased _____ in., _____ ft.

Sand _____

Gas _____

Oil _____

Total Depth 3237

PRODUCTION

1st 24 hrs. Nat. _____

1st 24 hrs. after shot _____

Gas _____ Cu. Ft.

Dry Hole _____

Abandoned _____

Date

SEP 25 1940 19

S. J. LEWIS Scout