

KANSAS

Ellsworth


Form 51—5M—7-40—Palace

Section 27 Township 17 Range 8-W

Well No. #7 Steinberg

Company Continental et al

NORTH Geneseo Pool

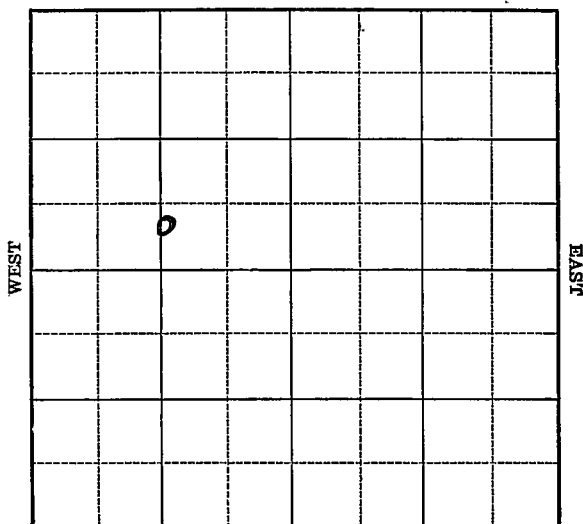


SOUTH

Sec. 27 Twp. 17 R. 8-WWell No. #7 Steinberg FarmContinental et al Company

(Geneseo)

 Ft. from N. Line440 Ft. from S. Line Ft. from E. Line137.6 Ft. from W. Line

Elev. 1777

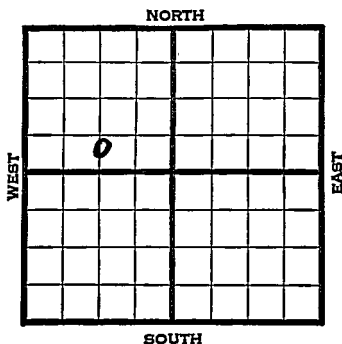

194

REPORT

2/26

Derrick.

3/6

.9" - 199' Drlg. 2015'

3/13

Arb. 3212-15' T.D. 6" - 3213'

RUST.

3/19

Arb. 3212'

6" - 3213'

T.D. 3227'

2000 acid.

Echometer potential 6862 bbls.

Maximum 3000 bbls.

40.1 Gravity

COMPLETED


Map No. 45 Sec. 27 Twp. 17 R. 8WWell No. 7 SteinbergContinental etal CompanyFIRST REPORT Contractor

C S L NW

 Ft. from N. Line440 Ft. from S. Line Ft. from E. Line1376 Ft. from W. Line

GENESEO POOL

SECTION PLAT

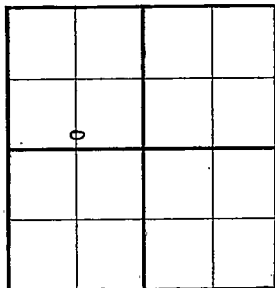Location Rig up

Drilling and Remarks:

Derrick

RECORD

Cased in., ft.Sand Gas Oil Total Depth

PRODUCTION

1st 24 hrs. Nat. 1st 24 hrs. after shot Gas Cu. Ft.Dry Hole Abandoned

Date

FEB 26 1941 19 S. J. LEWIS Scout

Map No. 45 Sec. 27 Twp. 17 R. 8WWell No. 7 SteinbergContinental etal CompanyCOMPLETED Contractor

C S L NW

 Ft. from N. Line440 Ft. from S. Line Ft. from E. Line1376 Ft. from W. Line

SECTION PLAT

GENESEO POOL

Location Rig up

Drilling and Remarks:

*Cr 83212**6 "C3218"**2000 and**Echo P 86862**Max 3000**40' Gr.*

RECORD

Cased in., ft.Sand Gas Oil Total Depth 5227

PRODUCTION

1st 24 hrs. Nat. 1st 24 hrs. after shot Gas Cu. Ft.Dry Hole Abandoned

Date

MAR 19 1941 19

S. J. LEWIS Scout