


Ellsworth

Section 27 ~~28~~ Township 17 Range 8-W

Well No. 2 Walt Steinberg

Company Continental et al

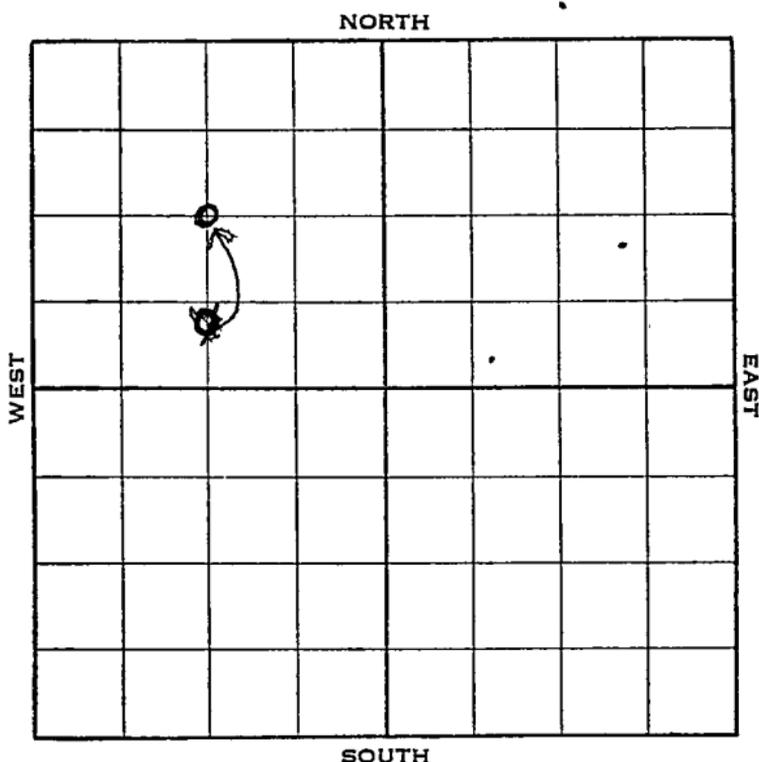



Map No. 45 Sec. 27 Twp. 17 R. 8WWell No. 2 Walt SteinbergContinental etal Company

Contractor

## FIRST REPORT

C S L NW

     Ft. from N. Line440 Ft. from S. Line     Ft. from E. Line1520 Ft. from W. Line

## SECTION PLAT


Location \_\_\_\_\_

Rig up \_\_\_\_\_

Drilling and Remarks:

S.H.

## RECORD

Cased \_\_\_\_\_ in., \_\_\_\_\_ ft.

Sand \_\_\_\_\_

Gas \_\_\_\_\_

Oil \_\_\_\_\_

Total Depth \_\_\_\_\_

## PRODUCTION

1st 24 hrs. Nat. \_\_\_\_\_

1st 24 hrs. after shot \_\_\_\_\_

Gas \_\_\_\_\_ Cu. Ft.

Dry Hole \_\_\_\_\_

Abandoned \_\_\_\_\_

Date

APR 27 1938 19 H. D. Hatfield Scout

*Ellsworth*

Map No. 45 Sec. 27 Twp. 17 R. S W

Well No. 2-Walt Steinberg  
Continental etal Company

Contractor

*CNW* CORRECTION

SECTION PLAT

	<i>5</i>		

1320 Ft. from N. Line

\_\_\_\_\_ Ft. from S. Line

\_\_\_\_\_ Ft. from E. Line

1320 Ft. from W. Line

CORRECTION

Location \_\_\_\_\_

Rig up \_\_\_\_\_

Drilling and Remarks:

*first reported  
as CSL NW  
Corrected to  
CNW*

RECORD

Cased \_\_\_\_\_ in., \_\_\_\_\_ ft.

Sand \_\_\_\_\_

Gas \_\_\_\_\_

Oil \_\_\_\_\_

Total Depth \_\_\_\_\_

PRODUCTION

1st 24 hrs. Nat. \_\_\_\_\_

1st 24 hrs. after shot \_\_\_\_\_

Gas \_\_\_\_\_ Cu. Ft.

Dry Hole \_\_\_\_\_

Abandoned \_\_\_\_\_

Date

MAY 18 1938

19

E. D. Hatfield

Scout

Map No. 45 Sec. 27 Twp. 17 R. 8W

Well No. 2 Walt Steinberg

Continental etal Company

Contractor

**COMPLETED**

C NW

1320 Ft. from N. Line

\_\_\_\_\_ Ft. from S. Line

\_\_\_\_\_ Ft. from E. Line

1320 Ft. from W. Line

**SECTION PLAT**

○			

Location \_\_\_\_\_

Rig up \_\_\_\_\_

Drilling and Remarks:

*POT 2473*

**RECORD**

Cased 7 in., 3214 ft.

Sand AB 3214

Gas \_\_\_\_\_

Oil \_\_\_\_\_

Total Depth 3247

**PRODUCTION**

1st 24 hrs. Nat. \_\_\_\_\_

1st 24 hrs. after shot \_\_\_\_\_

Gas \_\_\_\_\_ Cu. Ft.

Dry Hole \_\_\_\_\_

Abandoned \_\_\_\_\_

Date

JUN 8 - 1938

19

H. D. Hatfield Scout