

KANSAS

McPherson

FORM 51 5M 1-42 PETROL


Section 27 Township 17 Range 1W

Well No. # 1 Neirider

Company Westgate Greenland

Roxbury Pool NORTH

2

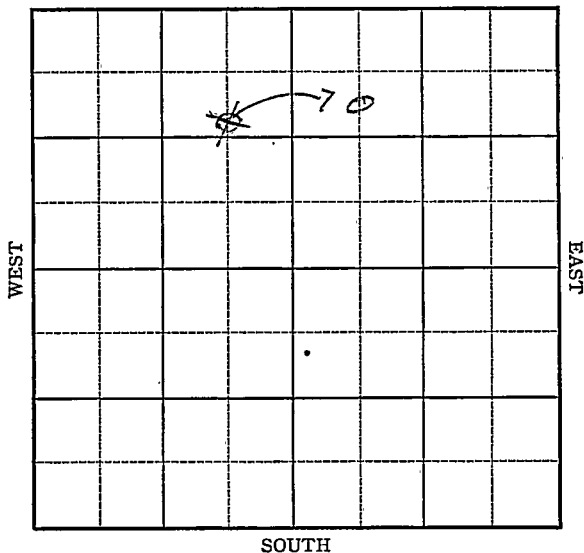

Sec. 27 Twp. 17 R. 1W


Well No. 1 Neirider Farm
Westgate Greenland Company
(Roxbury Pool)

990 Ft. from N. Line

 Ft. from S. Line

~~660~~ Ft. from E. Line

660 Ft. from W. Line

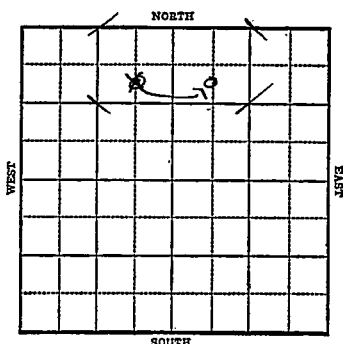

1942

R E P O R T

10/28 Rotary
11/4 10" @ 150' Drlg 1300
11/11 Chat 2718-28 TD
7" @ 2724' RUST
11/18 TD 2740-2000' oil in 3½ hrs.
11/24 Chab. 2718
7" @ 2724
T.D. 2740'
Echo Pot. 924 Oil plus 20% water.
Gravity 35

COMPLETED

Map No. 42 Sec. 27 Twp. 17 R. 1WWell No. 1 NeiriderWestgate Greenland Company

FIRST REPORT


Contractor

C S L NW NE

SECTION PLAT

990 Ft. from N. Line Ft. from S. Line660 Ft. from E. Line Ft. from W. Line

ROXBURY POOL

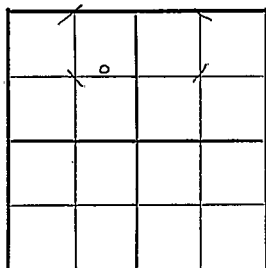Location Rig up

Drilling and Remarks:

Rotary

RECORD

Cased in., ft.Sand Gas Oil Total Depth

- PRODUCTION

1st 24 hrs. Nat. 1st 24 hrs. after shot Gas Cu. Ft.Dry Hole Abandoned

Date

OCT 28 1942 19S. J. LEWIS

Scout

McPhers on

KANSAS

Map No. 42 Sec. 27 Twp. 17 R. 1WWell No. 1 NeiriderWestgate-Greenland Company

COMPLETED

Contractor


C SL NW NE

check

SECTION PLAT

990 Ft. from N. Line Ft. from S. Line800 Ft. from E. Line660. Ft. from W. Line

Correct - spot to

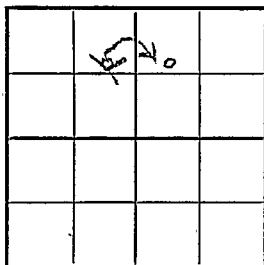ROXBURY POOL ^{Above}Location Rig up

Drilling and Remarks:

*Chas 2718**7" @ 2724**Echo Prod. 924 oil**+ 20% Water**35° Gr*

RECORD

Cased in., ft.Sand Gas Oil Total Depth 2740

PRODUCTION

1st 24 hrs. Nat. 1st 24 hrs. after shot Gas Cu. Ft.Dry Hole Abandoned

Date

NOV 24 1942 19 S. J. LEWIS Scout

11/28

Please check spot and feet measurements.

Oma

Misc Small Maps	<i>Oma</i>
Cards	<i>Root</i>
Tracing	<i>MB</i>
France Map	<i>✓</i>
Scarborough Map	<i>MB</i>
Moody Map	<i>MB</i>
Geological Dept.	
Moody Flat Book	